

Newton
E 36
4-17-73

MISSISSIPPI
 BOARD OF WATER COMMISSIONERS
 416 North State Street
 Jackson, Mississippi 39201

CODE

WATER WELL DRILLERS LOG

4-17 1973 W.L. Welch Newton
 date well completed firm name county well located

LANDOWNER: <u>Rennie Seal</u>	description of formations encountered	from	to
<u>Concho</u> <u>Miss</u> (mailing address)			
WELL LOCATION: sec. <u>29</u> T. <u>7</u> N. R. <u>10</u> E <u>3</u> miles <u>SW</u> of <u>Concho</u> (distance) (direction) (nearest town)	<u>Clay</u>	<u>0</u>	<u>76</u>
WELL PURPOSE: <u>Home</u> (home, irrigation, municipal, industrial)	<u>Blue Shell</u>	<u>16</u>	<u>40</u>
WELL COMPLETION DATA: (1) diameter (inches) <u>2"</u>	<u>Sandy</u>		
(2) total depth (feet) <u>420</u>	<u>Blue</u>	<u>52</u>	<u>190</u>
(3) static water level (feet) <u>84</u> below above top of ground.	<u>Blue Sandy</u>	<u>130</u>	<u>140</u>
(4) casing <u>Gal Steel 350</u> (material) (depth)	<u>Brown</u>	<u>140</u>	<u>200</u>
(5) screen <u>None</u> (length) (depth to top)	<u>Sand</u>	<u>200</u>	<u>300</u>
(6) pump <u>1 1/2</u> (HP) <u>350</u> (yield gpm)	<u>Light Brown</u>	<u>300</u>	<u>360</u>
(7) electric log (yes or no)	<u>Rocky</u>	<u>360</u>	<u>385</u>
(8) how well bottom plugged	<u>Green sand</u>	<u>385</u>	<u>400</u>

CODE


DRILLERS REMARKS:

Open Hole

MISS. ST. OF WATER

If well telescopes please sketch and show depths.

GROUND LEVEL

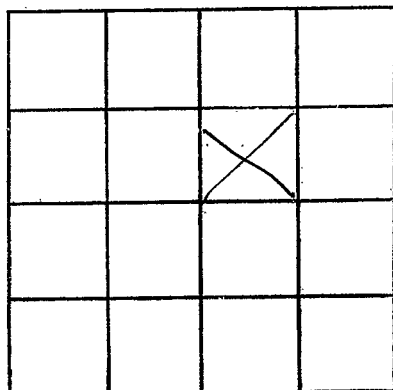

SECTION _____

Please indicate well location X.

ADDITIONAL INFORMATION

If more than one screen, show locations of each on sketch.