

**E 37**  
**NEWTON**  
**8-10-73**

MISSISSIPPI  
 BOARD OF WATER COMMISSIONERS  
 416 North State Street  
 Jackson, Mississippi 39201

**CODED**

**WATER WELL DRILLERS LOG**

8, 10, 73 19 McDONALD + HILL NEWTON  
 date well completed firm name county well located


LANDOWNER:	description of formations encountered	from	to
<u>CHARLES CARSON</u>	<u>Clay</u>	<u>0</u>	<u>8</u>
<u>CONEHATTA MISS</u> (mailing address)	<u>Sand &amp; Clay</u>	<u>8</u>	<u>35</u>
<b>WELL LOCATION:</b> sec. <u>16</u> T. <u>7</u> (N) R. <u>10</u> (E) <u>1</u> miles <u>Block</u> <u>SOUTH CONE</u> of <u>SOUTH CONE</u> (distance) (direction) (nearest town)	<u>Shale</u>	<u>35</u>	<u>70</u>
<b>WELL PURPOSE:</b> <u>HOME</u> (home, irrigation, municipal, industrial)	<u>Shale &amp; Shale</u>	<u>70</u>	<u>116</u>
<b>WELL COMPLETION DATA:</b>	<u>Shale</u>	<u>110</u>	<u>245</u>
(1) diameter (inches) <u>4"</u>	<u>sand</u>	<u>240</u>	<u>300</u>
(2) total depth (feet) <u>420</u>	<u>Shale</u>	<u>300</u>	<u>365</u>
(3) static water level (feet) <u>150</u> below top of ground.	<u>Rock &amp; Shale</u>	<u>365</u>	<u>390</u>
(4) casing <u>PVC</u> <u>340'</u> (material) (depth) <u>4"</u> (size) if telescope see back.	<u>SAND &amp; ST SHALE</u>	<u>390</u>	<u>420</u>
(5) screen _____ (length) (depth to top) (size) (material)			
(6) pump <u>3/4</u> <u>506</u> <u>10</u> (HP) (yield gpm) <u>ELECTRIC</u> (type power)			
(7) electric log _____ (yes or no) (organization running log)			
(8) how well bottom plugged <u>OPEN</u>			
<b>DRILLERS REMARKS:</b>			

**AUG 16 1973**

SET PUMP 210'

If well telescopes please sketch and show depths.

GROUND LEVEL

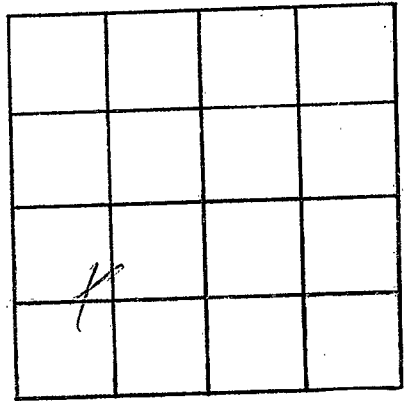

SECTION \_\_\_\_\_

Please indicate well location X.

ADDITIONAL INFORMATION

If more than one screen, show locations of each on sketch.