

E 38

NEWTON

6-6-73

MISSISSIPPI  
BOARD OF WATER COMMISSIONERS  
416 North State Street  
Jackson, Mississippi 39201

**CODED**

WATER WELL DRILLERS LOG

10-6-73  
date well completed

19 *Paul Corns Drilling*  
firm name

*Newton*  
county well located

LANDOWNER: *Paul Corns*

*Cornetta R#2 Miss*

(mailing address)

WELL LOCATION:

sec. *12* T *7* N R. *10* E

*1 1/2* miles *S* of *Cornetta*  
(distance) (direction) (nearest town)

WELL PURPOSE:

(home, irrigation, municipal, industrial)

WELL COMPLETION DATA:

- (1) diameter (inches) 4"
- (2) total depth (feet) 440
- (3) static water level (feet) 140 below top of ground.
- (4) casing Steel 361  
(material) (depth)  
         if telescope see back.  
(size)
- (5) screen          (length) (depth to top)  
         (size) (material)
- (6) pump          (HP) (yield gpm)  
         (type power)
- (7) electric log          (yes or no)  
         (organization running log)
- (8) how well bottom plugged

description of formations encountered

from

to

<i>Clay</i>	<i>0</i>	<i>87</i>
<i>Sand + Clay</i>	<i>89</i>	<i>128</i>
<i>Sand</i>	<i>128</i>	<i>166</i>
<i>Clay</i>	<i>166</i>	<i>102</i>
<i>Sand</i>	<i>102</i>	<i>124</i>
<i>Clay + Sand</i>	<i>124</i>	<i>314</i>
<i>Sand</i>	<i>314</i>	<i>342</i>
<i>Rock + Shell</i>	<i>342</i>	<i>355</i>
<i>Clay</i>	<i>355</i>	<i>412</i>
<i>Rock + Clay</i>	<i>412</i>	<i>425</i>
<i>Sand</i>	<i>425</i>	<i>440</i>


**AUG 20 1973**

DRILLERS REMARKS:

*Open Bottom From 361 to 440 feet*

If well telescopes please sketch and show depths.

GROUND LEVEL

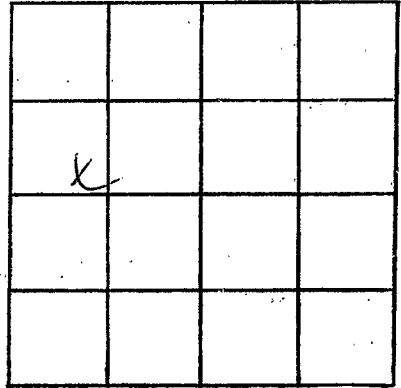

SECTION \_\_\_\_\_

Please indicate well location X.

ADDITIONAL INFORMATION

If more than one screen, show locations of each on sketch.