

NEWTON

E 40

9-5-73

MISSISSIPPI BOARD OF WATER COMMISSIONERS 416 North State Street Jackson, Mississippi 39201

CODED

WATER WELL DRILLERS LOG

9-5 date well completed 1973 U. S. Shaleh Newton firm name county well located

LANDOWNER: B. Kube

Lawrence (mailing address)

description of formations encountered	from	to
Clay	0	16
Sand	16	80
S. Blue	80	120
Sand	120	157

WELL LOCATION:

sec. 33 T. 7 N R. 10 E 1/2 miles N of Lawrence (distance) (direction) (nearest town)

WELL PURPOSE: home (home, irrigation, municipal, industrial)

WELL COMPLETION DATA:

- (1) diameter (inches) 2"
- (2) total depth (feet) 157
- (3) static water level (feet) 49 below top of ground
- (4) casing 2 1/2" Steel (material) (depth) If telescope see back. (size)
- (5) screen 6 (length) (depth to top) 2 1/2" S. Steel (size) (material)
- (6) pump 1 (HP) 800 (yield gpm) (type power)
- (7) electric log (yes or no) (organization running log)
- (8) how well bottom plugged

CODED

60' 800 10' 1/2"

SEP 11 1973


UNDER 20. OF WATER METER

DRILLERS REMARKS:

Pump with Air

If well telescopes please sketch and show depths.

GROUND LEVEL

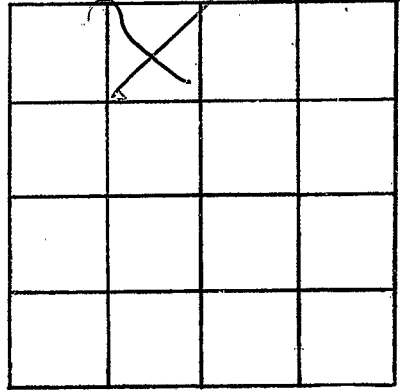

SECTION _____

Please indicate well location X.

ADDITIONAL INFORMATION

If more than one screen, show locations of each on sketch.