

NEWTON

E 41

8-28-73

MISSISSIPPI BOARD OF WATER COMMISSIONERS
416 North State Street
Jackson, Mississippi 39201

CODED

WATER WELL DRILLERS LOG

8-28 1973
date well completed

J. S. Welch Newton
firm name county well located

LANDOWNER: D. Jacobs

description of formations encountered

from to

Conehatta

Clay 0 18

Miss (mailing address)

Blue & Shal 18 40

WELL LOCATION:

sec 33 T 7 N R 10 E
2 miles S of Conehatta
(distance) (direction) (nearest town)

Blue 40 75

Blue Shal 75 90

WELL PURPOSE: home
(home, irrigation, municipal, industrial)

Brown Sand 90 120

WELL COMPLETION DATA:

Blue & Brown 120 140

- (1) diameter (inches) 3"
- (2) total depth (feet) 200
- (3) static water level (feet) 64 below top of ground
- (4) casing 3/4" steel (material), (depth)

Sandy 140 180

Gravel 180 200

CODED

if telescope see back.

- (5) screen 10' (length), (depth to top)
3/4" 5 steel (size) (material)
- (6) pump 1/2 (HP), 350 (yield gpm)
e pump (type power)

(7) electric log (yes or no)

(organization running log)

(8) how well bottom plugged


DRILLERS REMARKS:

SEP 11 1973

MISS. Bd. OF WATER COMMISSIONERS

If well telescopes please sketch and show depths.

GROUND LEVEL

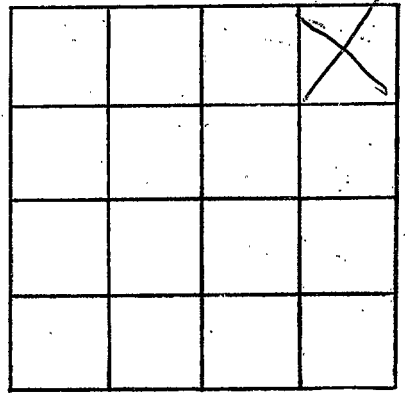

SECTION _____

Please indicate well location X.

ADDITIONAL INFORMATION

If more than one screen, show locations of each on sketch.