

**NEWTON**  
**E 42**  
**11-2-73**

**MISSISSIPPI**  
**BOARD OF WATER COMMISSIONERS**  
 416 North State Street  
 Jackson, Mississippi 39201 **CODED**

**WATER WELL DRILLERS LOG**

11. 2. 73 19 McDONALD + HILL NEWTON  
 date well completed      firm name      county well located

**LANDOWNER:**  
JAMES R MAYES  
R#1 DECATUR  
 (mailing address)

description of formations encountered	from	to
<u>Clay</u>	<u>0</u>	<u>20</u>
<u>Sand</u>	<u>20</u>	<u>35</u>
<u>Shale</u>	<u>35</u>	<u>90</u>
<u>Shale &amp; sand</u>	<u>90</u>	<u>140</u>
<u>Sand</u>	<u>140</u>	<u>240</u>
<u>Soft shale</u>	<u>240</u>	<u>260</u>
<u>Shale</u>	<u>260</u>	<u>330</u>
<u>Sand</u>	<u>330</u>	<u>360</u>

**WELL LOCATION:**  
 sec 13 T 7 N 5 R 10 E  
4 miles WEST of DECATUR  
 (distance) (direction) (nearest town)

**WELL PURPOSE:** HOME  
 (home, irrigation, municipal, industrial)

- WELL COMPLETION DATA:**
- (1) diameter (inches) 4"
  - (2) total depth (feet) 360
  - (3) static water level (feet) 180' below top of ground.
  - (4) casing pvc 270'  
 (material) (depth)  
4"  
 (size) if telescope see back.
  - (5) screen \_\_\_\_\_  
 (length) (depth to top)  
 (size) (material)
  - (6) pump 24 10  
 (HP) (yield gpm)  
ELECTRIC  
 (type power)
  - (7) electric log \_\_\_\_\_  
 (yes or no)  
 (organization running log)
  - (8) how well bottom plugged OPEN


**CODED**

**NOV 15 1973**

**DRILLERS REMARKS:**

If well telescopes please sketch and show depths.

GROUND LEVEL

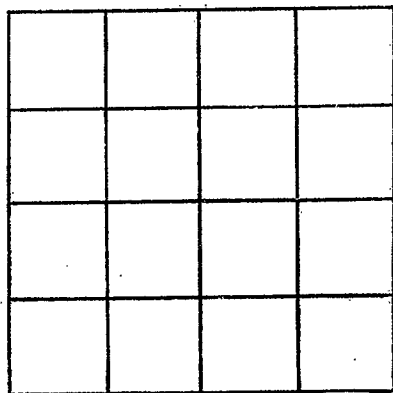

SECTION \_\_\_\_\_

Please indicate well location X:

ADDITIONAL INFORMATION

If more than one screen, show locations of each on sketch.