

NEWTON
E43
5-15-74

MISSISSIPPI
BOARD OF WATER COMMISSIONERS
416 North State Street
Jackson, Mississippi 39201

CODED

WATER WELL DRILLERS LOG

5-15-74
date well completed

McDONALD + HILL
firm name

NEWTON
county well located

LANDOWNER:

GEORGE ALLGOOD

R#1 DECATOR

(mailing address)

WELL LOCATION:

sec. 13 T-7 N R-10 E
S
6 miles WEST of DECATOR
(distance) (direction) (nearest town)

WELL PURPOSE: INDOME
(home, irrigation, municipal, industrial)

WELL COMPLETION DATA:

- (1) diameter (inches) 4 1/4
(2) total depth (feet) 360
(3) static water level (feet) 200' below top of ground.
(4) casing PVC 265'
(material) (depth)
4"
(size) if telescope see back.
(5) screen _____
(length) (depth to top)
(size) (material)
(6) pump 3/4 Sub 6
(HP) (yield gpm)
E
(type power)
(7) electric log ✓
(yes or no)
(organization running log)
(8) how well bottom plugged OPEN

description of formations encountered

from to

SAND CLAY	0	20
SHALE	20	40
SANDY ST. SHALES	40	75
SAND ST. CLAY	75	130
SHALE	130	140
SAND	140	225
SANDY ST. SHALE	225	250
SHALE	250	295
ROCK ST. SHALE	295	320
SAND ST. SHALE	320	360

CODED


DECATOR
MAY 20 1974

DRILLERS REMARKS:

MISS. BD. OF WATER COMMISSIONERS

If well telescopes please sketch and show depths.

GROUND LEVEL

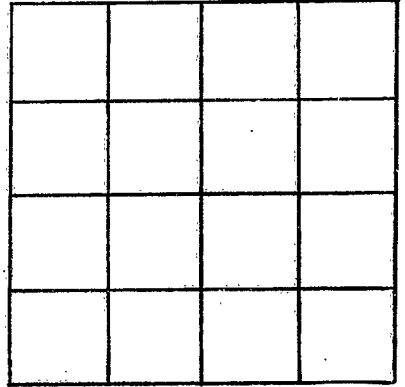

SECTION _____

Please indicate well location X.

ADDITIONAL INFORMATION

If more than one screen,
show locations of each on sketch.