

MISSISSIPPI DEPARTMENT OF NATURAL RESOURCES

Bureau of Land and Water Resources

Southport Mall

P.O. Box 10631

Jackson, Mississippi 39209

CODED

WATER WELL DRILLERS LOG

NEWTON

E 46

11-1-84

McDonald & Well

Newton

date well completed

firm name

county well located

LANDOWNER:

R. D. Kelly

Rt 1 Box 282

(mailing address)

WELL LOCATION:

sec 26 T 7 N R 10 E

4 miles SE of Cornhatt

(distance) (direction) (nearest town)

WELL PURPOSE:

none (home, irrigation, municipal, industrial)

WELL COMPLETION DATA:

- (1) diameter (inches) 4"
- (2) total depth (feet) 360'
- (3) static water level (feet) 140' below top of ground.
- (4) casing PVC 265' (material) (depth) 4" (size) if telescope see back.
- (5) screen (length) (depth to top) (size) (material)
- (6) pump 30 (HP) 85 gpm (material) (yield gpm)
- (7) electric log (yes or no) (organization running log)
- (8) how well bottom plugged open

description of formations encountered

from to

Clay & sand 0 17

shale 17 40

sandy shale 40 60

shale & sand 60 120

sand 120 225

sandy shale 225 250

shale 250 301

rock & shell 301 320

greensand 320 340

sandy shale & PVC casing 340 360

CODED

DEPT. OF NATURAL RESOURCES
BUREAU OF LAND & WATER RESOURCES

NOV 7 1984


RECEIVED

DRILLERS REMARKS:

WPCES

All telescopes please
and show depths.

GROUND LEVEL

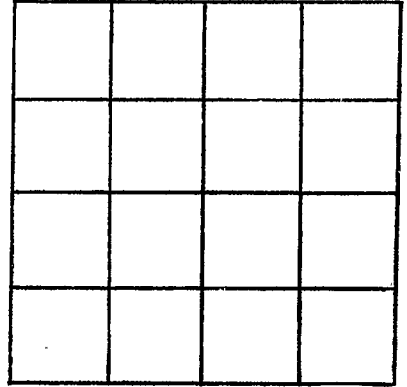

SECTION _____

Please indicate well location X.

ADDITIONAL INFORMATION

If more than one screen,
show locations of each on sketch.