

E49 ^{OP} 10/05
~~2017~~
 6-5-80

MISSISSIPPI
 BOARD OF WATER COMMISSIONERS
 416 North State Street
 Jackson, Mississippi 39201

WATER WELL DRILLERS LOG

6-5-80 19 McDonald & Hill Newton
 date well completed firm name county well located

LANDOWNER:	description of formations encountered	from	to
<u>Frankie Edwards</u>	<u>clay & sand</u>	<u>0</u>	<u>25</u>
<u>Conchatta</u> (mailing address)	<u>shale</u>	<u>25</u>	<u>50</u>
WELL LOCATION: <u>502 TOWN RICE</u>	<u>sand shell & clay</u>	<u>50</u>	<u>60</u>
sec <u>35</u> T <u>8</u> N R <u>10</u> E	<u>fine sand & sandy shale</u>	<u>60</u>	<u>80</u>
<u>4</u> miles <u>NW</u> of <u>Conchatta</u>	<u>sand & shale</u>	<u>80</u>	<u>220</u>
(distance) (direction) (nearest town)	<u>sandy shale</u>	<u>220</u>	<u>260</u>
WELL PURPOSE: <u>home</u> (home, irrigation, municipal, industrial)	<u>shale</u>	<u>260</u>	<u>285</u>
WELL COMPLETION DATA:	<u>Rock & shells</u>	<u>285</u>	<u>328</u>
(1) diameter (inches) <u>4"</u>	<u>green sand</u>	<u>328</u>	<u>330</u>
(2) total depth (feet) <u>320'</u>			
(3) static water level (feet) <u>170'</u> below above top of ground.			
(4) casing <u>PVC</u> , <u>270'</u> , (material) (depth) <u>4"</u> (size) if telescope see back.			
(5) screen _____ (length) (depth to top) (size) (material)			
(6) pump <u>31</u> <u>89 gpm</u> (HP) (field gpm) <u>F</u> (type power)			
(7) electric log _____ (yes or no) (organization running log)			
(8) how well bottom plugged <u>open</u>			
DRILLERS REMARKS:			


DEPT. OF NATURAL RESOURCES
 BUREAU OF LAND & WATER RESOURCES

JUN 12 1980

RECEIVED

If well telescopes please
sketch and show depths.

GROUND LEVEL

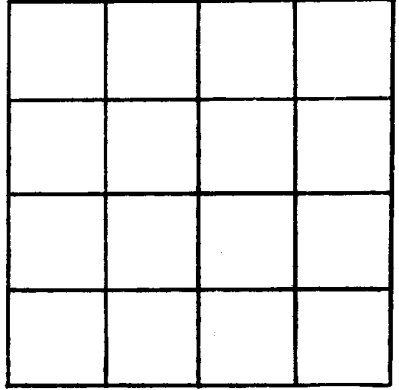

SECTION _____

Please indicate well location X.

ADDITIONAL INFORMATION

If more than one screen,
show locations of each on sketch.