

NEWTON

E 2001

5-4-76

MISSISSIPPI BOARD OF WATER COMMISSIONERS 416 North State Street Jackson, Mississippi 39201

WATER WELL DRILLERS LOG

5-4 1976 date well completed

W.L. Shelch firm name

Newton county well located

LANDOWNER:

Ralph Vaughan Decatur Miss (mailing address)

description of formations encountered

from to

yellow clay 0 18

blue 18 20

blue + shell 20 30

broken sandy 30 120

gray sandy 120 140

sand 140 180

WELL LOCATION:

sec. 14T 7N S R 10E W 10 miles N of Lawrence (distance) (direction) (nearest town)

WELL PURPOSE: Home (home, irrigation, municipal, industrial)

WELL COMPLETION DATA:

- (1) diameter (inches) 2"
(2) total depth (feet) 190
(3) static water level (feet) 55 below top of ground.

(4) casing PVC (material) (depth) If telescope see back. (size)

(5) screen 5' (length) (depth to top)

3" PVC (size) (material)

(6) pump 1 (HP) 350 (yield gpm)

elec (type power)

(7) electric log (yes or no)

(organization running log)


(8) how well bottom plugged

DRILLERS REMARKS:

MISSISSIPPI BOARD OF WATER COMMISSIONERS JUN - 7 1976 MISS. Bd. of Water Comm.

If well telescopes please sketch and show depths.

GROUND LEVEL

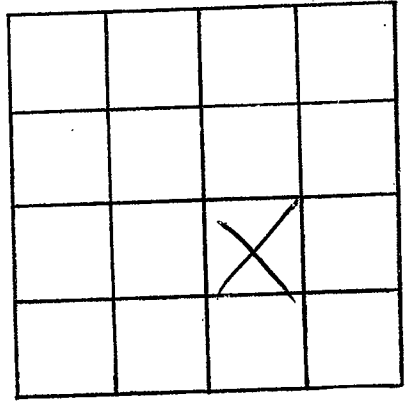

SECTION _____

Please indicate well location X.

ADDITIONAL INFORMATION

If more than one screen,
show locations of each on sketch.