

Newton
E 2002
10-20-76

MISSISSIPPI
 BOARD OF WATER COMMISSIONERS
 416 North State Street
 Jackson, Mississippi 39201

137

WATER WELL DRILLERS LOG

10-20 1976 Mr. Donald H. Hill Newton
 date well completed firm name county well located

LANDOWNER: Ervin Anderson
Conchotta, Miss.
 (mailing address)

WELL LOCATION:
 sec. 9 T 7 N R 10 E
 S W
3/4 miles N. of Conchotta
 (distance) (direction) (nearest town)

WELL PURPOSE:
 (home, irrigation, municipal, industrial)

WELL COMPLETION DATA:
 (1) diameter (inches) 4"
 (2) total depth (feet) 400'
 (3) static water level (feet) 135' below above
 top of ground.
 (4) casing PVC, 295'
 (material) (depth)
 4" If telescope see back.
 (size)
 (5) screen (length) (depth to top)
 (size) (material)
 (6) pump 3/4 10
 (HP) (yield gpm)
 (type power)
 (7) electric log (yes or no) ✓
 (organization running log)
 (8) how well bottom plugged OPEN


description of formations encountered	from	to
<u>Clay</u>	<u>0</u>	<u>18</u>
<u>Shale</u>	<u>18</u>	<u>55</u>
<u>Sand & Shells</u>	<u>55</u>	<u>65</u>
<u>Shale & sand</u>	<u>65</u>	<u>95</u>
<u>Shale & lignite</u>	<u>95</u>	<u>110</u>
<u>Sand & shale</u>	<u>110</u>	<u>155</u>
<u>Sand</u>	<u>155</u>	<u>205</u>
<u>sandy shale & sand</u>	<u>205</u>	<u>280</u>
<u>shale</u>	<u>280</u>	<u>325</u>
<u>Rock & shale</u>	<u>325</u>	<u>360</u>
<u>sandy shale & sand</u>	<u>360</u>	<u>385</u>
<u>shale & rock</u>	<u>385</u>	<u>400</u>

RECEIVED
 OCT 26 1976
 MISS. BD. OF WATER COMMISSIONERS

DRILLERS REMARKS:

If well telescopes please sketch and show depths.

GROUND LEVEL

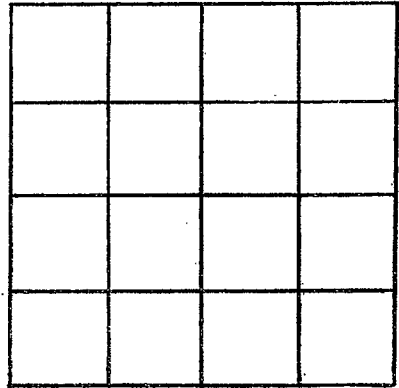

SECTION _____

Please indicate well location X.

ADDITIONAL INFORMATION

If more than one screen, show locations of each on sketch.