

Newton
E 2003
11-30-76

MISSISSIPPI
 BOARD OF WATER COMMISSIONERS
 416 North State Street
 Jackson, Mississippi 39201

137

WATER WELL DRILLERS LOG

11-30 1976 McDonald & Hill Newton
 date well completed firm name county well located

LANDOWNER:
Houston Leach
Rt #1 Conehatta
 (mailing address)

description of formations encountered	from	to
	<u>clay</u>	<u>0</u>
<u>shale</u>	<u>18</u>	<u>60</u>

WELL LOCATION:
 sec. 4 T. 7 N R. 10 E
4 miles N of Conehatta
 (distance) (direction) (nearest town)

<u>sandy</u>	<u>60</u>	<u>70</u>
<u>shale & sand</u>	<u>70</u>	<u>110</u>
<u>sand</u>	<u>110</u>	<u>225</u>

WELL PURPOSE: home
 (home, irrigation, municipal, industrial)

<u>sandy shale</u>	<u>225</u>	<u>265</u>
--------------------	------------	------------

- WELL COMPLETION DATA:
- diameter (inches) 4"
 - total depth (feet) 360'
 - static water level (feet) 150 below above top of ground.
 - casing PVC 280'
 (material) (depth)
4"
 (size) if telescope see back.
 - screen _____
 (length) (depth to top)

 (size) (material)
 - pump 3/4 50 GPM
 (HP) (yield gpm)
sub
 (type power)
 - electric log NO
 (yes or no)

 (organization running log)
 - how well bottom plugged open

<u>shale</u>	<u>265</u>	<u>305</u>
<u>Rock & shell</u>	<u>305</u>	<u>330</u>
<u>sand</u>	<u>330</u>	<u>360</u>


DRILLERS REMARKS:

RECEIVED
 DEC 6 1976

MISS. BD. OF WATER COMMISSIONERS

If well telescopes please sketch and show depths.

GROUND LEVEL

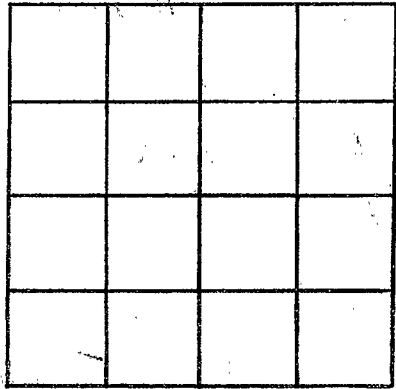

SECTION _____

Please indicate well location X.

ADDITIONAL INFORMATION

If more than one screen,
show locations of each on sketch.