

Newton
E 2004
1/5/77

MISSISSIPPI
 BOARD OF WATER COMMISSIONERS
 416 North State Street
 Jackson, Mississippi 39201

13T

WATER WELL DRILLERS LOG

1-5-77 19 McDonald + Hill Newton
 date well completed firm name county well located


LANDOWNER:	description of formations encountered	from	to
<u>Dwight Jacob</u>			
<u>Rt #1 Lawrence</u> (mailing address)	<u>sandy</u>	<u>20</u>	<u>110</u>
WELL LOCATION:	<u>shale</u>	<u>110</u>	<u>125</u>
sec. <u>33T 7N</u> R. <u>10E</u>	<u>shale st sand</u>	<u>125</u>	<u>160</u>
<u>3</u> miles <u>south</u> of <u>Canehatta</u>	<u>sand</u>	<u>160</u>	<u>265</u>
(distance) (direction) (nearest town)	<u>sandy shale + Rock</u>	<u>265</u>	<u>320</u>
WELL PURPOSE: <u>home</u> (home, irrigation, municipal, industrial)	<u>shale</u>	<u>320</u>	<u>360</u>
WELL COMPLETION DATA:	<u>Rock + shells</u>	<u>360</u>	<u>390</u>
(1) diameter (inches) <u>4"</u>	<u>sand</u>	<u>390</u>	<u>420</u>
(2) total depth (feet) <u>420'</u>			
(3) static water level (feet) <u>84'</u> below top of ground.			
(4) casing <u>PVC</u> , <u>345'</u> (material) (depth)			
<u>4"</u> (size) If telescope see back.			
(5) screen _____ (length) (depth to top)			
(size) (material)			
(6) pump <u>3/4</u> <u>5900</u> (HP) (yield gpm)			
<u>sub</u> (type power)			
(7) electric log _____ (yes or no)			
(organization running log)			
(8) how well bottom plugged <u>open</u>			
DRILLERS REMARKS:			

RECEIVED
 JAN 10 1977

MISSISSIPPI BOARD OF WATER COMMISSIONERS

If well telescopes please sketch and show depths.

GROUND LEVEL

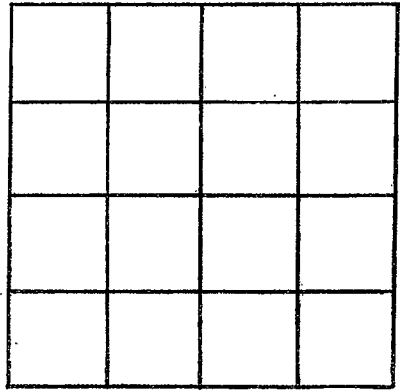

SECTION _____

Please indicate well location X.

ADDITIONAL INFORMATION

If more than one screen,
show locations of each on sketch.