

NEWTON
E 2007
3-19-77


MISSISSIPPI
BOARD OF WATER COMMISSIONERS
 416 North State Street
 Jackson, Mississippi 39201

13T

WATER WELL DRILLERS LOG

3-19-77 date well completed
 McDonald & Hill firm name
 Newton county well located

LANDOWNER:	description of formations encountered	from	to
Colbert Phillips Rt # 1 Decatur (mailing address)			
WELL LOCATION:	shale	25	100
sec. <u>1</u> T. <u>2</u> N. R. <u>10</u> E	sandy shale	100	140
<u>8</u> miles <u>NW</u> of <u>Newton</u>	shales + sand	140	235
(distance) (direction) (nearest town)	sand	235	335
WELL PURPOSE:	sandy shale	335	360
(home, irrigation, municipal, industrial)	shale	360	425
WELL COMPLETION DATA:	rocks + shale	425	430
(1) diameter (inches) <u>4"</u>	green sand	430	460
(2) total depth (feet) <u>460'</u>			
(3) static water level (feet) <u>150'</u> below top of ground.			
(4) casing <u>PVC</u> , <u>380'</u> (material) (depth)			
<u>4"</u> (size) If telescope see back.			
(5) screen _____ (length) (depth to top)			
(size) (material)			
(6) pump <u>3/4</u> <u>5900</u> (HP) (1/2" d gpm)			
(type power) <u>E</u>			
(7) electric log _____ (yes or no)			
(organization running log)			
(8) how well bottom plugged <u>open</u>			
DRILLERS REMARKS:			

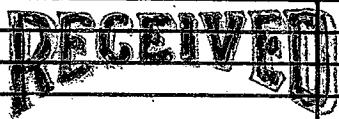


MAR 28 1977

MISS. BD. OF WATER COMM.

If well telescopes please sketch and show depths.

GROUND LEVEL

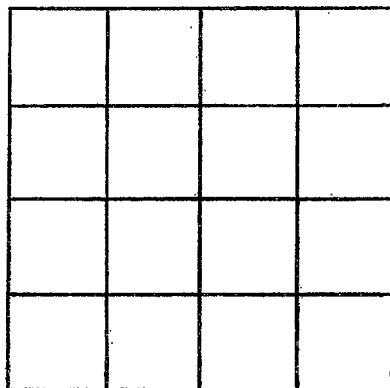

SECTION _____

Please indicate well location X.

ADDITIONAL INFORMATION

If more than one screen,
show locations of each on sketch.