

NEWTON
E 2008
4-12-77

MISSISSIPPI
BOARD OF WATER COMMISSIONERS
416 North State Street
137 Jackson, Mississippi 39201

WATER WELL DRILLERS LOG

4-12-77 19 McDonald & Well Newton
date well completed firm name county well located

LANDOWNER:
Roger Mitchell
Rt #1 Conchatta
(mailing address)

description of formations encountered	from	to
	clay	0
shale & sand	20	25

WELL LOCATION:
sec. 1 T. 7 N. R. 10 E.
5 miles NE of Conchatta
(distance) (direction) (nearest town)

WELL PURPOSE: domestic
(home, irrigation, municipal, industrial)

WELL COMPLETION DATA:

(1) diameter (inches) 2"

(2) total depth (feet) 75'

(3) static water level (feet) 42' below top of ground.

(4) casing PVC, 20' (material) (depth)
2" (size) if telescope see back.

(5) screen 5, 70'-75' (length) (depth to top)
2, PVC (size) (material)

(6) pump 1/2, 30 gpm (HP) (yield gpm)
F (type power)

(7) electric log (yes or no)
(organization running log)

(8) how well bottom plugged valve

RECEIVED


APR 18 1977

DRILLERS REMARKS:

MISS. BD. OF WATER COMMISSIONERS

If well telescopes please
sketch and show depths.

GROUND LEVEL

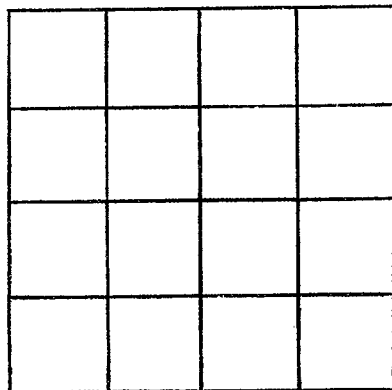

SECTION _____

Please indicate well location X.

ADDITIONAL INFORMATION

If more than one screen,
show locations of each on sketch.