

NEWTON
E 2011
9-20-77

MISSISSIPPI
 BOARD OF WATER COMMISSIONERS
 416 North State Street
 Jackson, Mississippi 39201

WATER WELL DRILLERS LOG

9-20-77
 date well completed

137

McDonald + Hill
 firm name

Newton
 county well located

LANDOWNER:	description of formations encountered	from	to
Jim Evans	clay + sand	0	16
Rt 1 Lawrence (mailing address)	shale	16	25
WELL LOCATION:	runny shale at Park	25	65
sec. <u>34</u> T <u>7</u> N <u>5</u> S R <u>10</u> E	sand + shale	65	140
<u>3</u> miles <u>S</u> of <u>Corhatta</u>	sand	140	150
(distance) (direction) (nearest town)			
WELL PURPOSE: <u>home</u> (home, irrigation, municipal, industrial)			
WELL COMPLETION DATA:			
(1) diameter (inches) <u>2"</u>			
(2) total depth (feet) <u>150'</u>			
(3) static water level (feet) <u>60'</u> below top of ground.			
(4) casing <u>PVC 145'</u> (material) (depth)			
<u>2"</u> if telescope see back. (size)			
(5) screen <u>5'</u> <u>145 to 150'</u> (length) (depth to top)			
<u>2"</u> <u>PVC</u> (size) (material)			
(6) pump <u>3/4</u> <u>49 gpm</u> (HP) (yield gpm)			
<u>F</u> (type power)			
(7) electric log <u>—</u> (yes or no)			
(organization running log)			
(8) how well bottom plugged <u>value</u>			
DRILLERS REMARKS:			


RECEIVED

SEP 26 1977

MISS. Bd. OF WATER COMM

If well telescopes please sketch and show depths.

GROUND LEVEL

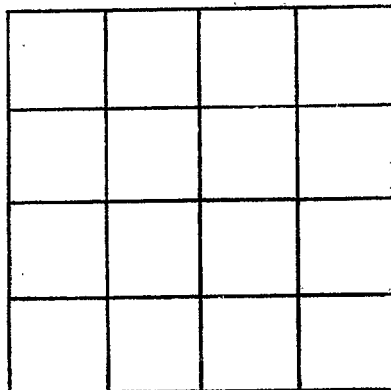

SECTION _____

Please indicate well location X.

ADDITIONAL INFORMATION

If more than one screen, show locations of each on sketch.