

NEWTON
E 2012
10-12-77

MISSISSIPPI
 BOARD OF WATER COMMISSIONERS
 416 North State Street
 Jackson, Mississippi 39201

WATER WELL DRILLERS LOG

10-12-77^{13T} 19 McDonald & Hill Newton
 date well completed firm name county well located


LANDOWNER:	description of formations encountered	from	to
<u>Charter Utilities</u> <u>Corner</u> <u>Mack Wilkerson job</u>	<u>clay & sand</u>	<u>0</u>	<u>16</u>
<u>Conehatta</u> (mailing address)	<u>sandy shale & sand</u>	<u>16</u>	<u>85</u>
WELL LOCATION: sec. <u>20</u> T- <u>2</u> (N) R- <u>10</u> (E) <u>2</u> miles <u>S</u> of <u>Conehatta</u> (distance) (direction) (nearest town)	<u>shale & sand</u>	<u>85</u>	<u>150</u>
WELL PURPOSE: <u>home</u> (home, irrigation, municipal, industrial)	<u>Brown shale</u>	<u>150</u>	<u>170</u>
WELL COMPLETION DATA: (1) diameter (inches) <u>4"</u> (2) total depth (feet) <u>420'</u> (3) static water level (feet) <u>95'</u> below top of ground. (4) casing <u>PVC 320'</u> (material) (depth) <u>4"</u> (size) if telescope see back. (5) screen (length) (depth to top) (size) (material) (6) pump <u>3/4</u> (HP) <u>600</u> (yield gpm) <u>F</u> (type power) (7) electric log (yes or no) (organization running log) (8) how well bottom plugged <u>open</u>	<u>sand</u>	<u>170</u>	<u>265</u>
	<u>sandy shale</u>	<u>265</u>	<u>305</u>
	<u>shale</u>	<u>305</u>	<u>355</u>
	<u>Rock & shells</u>	<u>355</u>	<u>390</u>
	<u>sandy & sandy shale</u>	<u>390</u>	<u>420</u>
DRILLERS REMARKS:			

RECEIVED
 OCT 25 1977

WATER COMMISSIONERS

If well telescopes please
sketch and show depths.

GROUND LEVEL

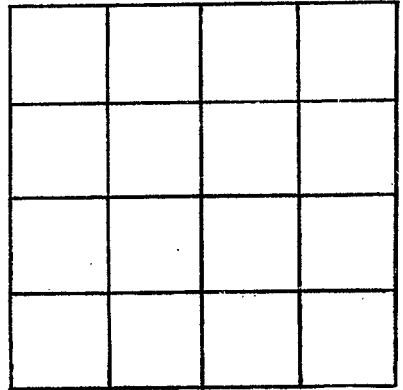

SECTION _____

Please indicate well location X.

ADDITIONAL INFORMATION

If more than one screen,
show locations of each on sketch.