

NEWTON
E 2013
10-26-77

MISSISSIPPI
 BOARD OF WATER COMMISSIONERS
 416 North State Street
 Jackson, Mississippi 39201

WATER WELL DRILLERS LOG

10-26-77 19 McDonald & Mill Newton
 date well completed firm name county well located


LANDOWNER:	description of formations encountered	from	to
<u>James Leach</u>	<u>clay & sand</u>	<u>0</u>	<u>22</u>
<u>RT #1 Lawrence</u> (mailing address)	<u>sand</u>	<u>22</u>	<u>80</u>
WELL LOCATION:	<u>shale</u>	<u>80</u>	<u>100</u>
sec. <u>21</u> T. <u>7N</u> R. <u>10E</u>	<u>sandy shale</u>	<u>100</u>	<u>160</u>
<u>3</u> miles <u>SW</u> of <u>Conhatta</u>	<u>sand & shale</u>	<u>160</u>	<u>240</u>
(distance) (direction) (nearest town)	<u>sand</u>	<u>240</u>	<u>375</u>
WELL PURPOSE: <u>home</u> (home, irrigation, municipal, industrial)	<u>sandy shale</u>	<u>375</u>	<u>405</u>
WELL COMPLETION DATA:	<u>shale</u>	<u>405</u>	<u>465</u>
(1) diameter (inches) <u>4"</u>	<u>Rock & shells</u>	<u>465</u>	<u>500</u>
(2) total depth (feet) <u>528'</u>	<u>green sand</u>	<u>500</u>	<u>520</u>
(3) static water level (feet) <u>135'</u> below top of ground.			
(4) casing <u>PVC</u> <u>417'</u> (material) (depth)			
<u>4"</u> (size) if telescope see back.			
(5) screen _____ (length) (depth to top)			
(size) (material)			
(6) pump <u>1 1/2</u> <u>10 gpm</u> (HP) (yield' gpm)			
(type power) <u>E</u>			
(7) electric log _____ (yes or no)			
(organization running log) _____			
(8) how well bottom plugged <u>open</u>			
DRILLERS REMARKS:			

RECEIVED
 OCT 31 1977

MISS. BD. OF WATER COM.

If well telescopes please sketch and show depths.

GROUND LEVEL

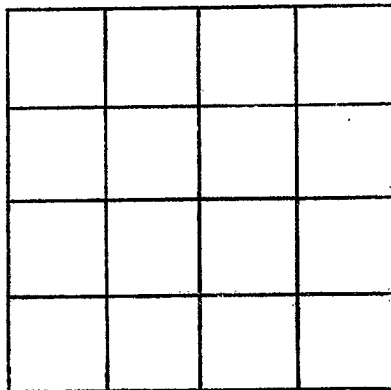

SECTION _____

Please indicate well location X.

ADDITIONAL INFORMATION

If more than one screen, show locations of each on sketch.