

NEWTON  
E 2015  
2/15/78

MISSISSIPPI  
BOARD OF WATER COMMISSIONERS  
416 North State Street  
Jackson, Mississippi 39201

WATER WELL DRILLERS LOG

2-15-78 date well completed  
McDonald & Hill firm name  
Newton county well located

LANDOWNER:  
Jack Germany  
Rt #1, Box 24 Conehatta  
(mailing address)

WELL LOCATION:  
sec. 9 T. 7 N. R. 10 E  
1 1/2 miles N of Conehatta  
(distance) (direction) (nearest town)

WELL PURPOSE: home  
(home, irrigation, municipal, industrial)

- WELL COMPLETION DATA:
- (1) diameter (inches) 4"
  - (2) total depth (feet) 380'
  - (3) static water level (feet) 110' below top of ground.
  - (4) casing PVC 300' (material) (depth)  
4" (size) If telescope see back.
  - (5) screen (length) (depth to top)  
(size) (material)
  - (6) pump 3/4 HP 6 gpm (HP) (yield gpm)  
E (type power)
  - (7) electric log (yes or no)  
(organization running log)
  - (8) how well bottom plugged Open

description of formations encountered	from	to
clay & sand	0	20
sandy shale	20	65
sand shale lignite	65	105
shale	105	145
sand	145	245
sandy shale	245	280
shale	280	330
Rock & shale	330	360
green sand & sandy shale	360	380


RECEIVED  
FEB 21 1978

DRILLERS REMARKS:

MISS. BD. OF WATER COMM

If well telescopes please sketch and show depths.

GROUND LEVEL

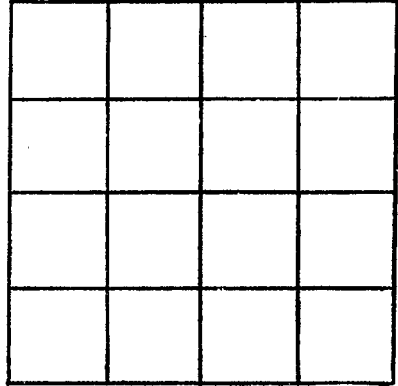

SECTION \_\_\_\_\_

Please indicate well location X.

ADDITIONAL INFORMATION

If more than one screen, show locations of each on sketch.