

NEWTON
E 2016
2/17/78

MISSISSIPPI
BOARD OF WATER COMMISSIONERS
416 North State Street
Jackson, Mississippi 39201

WATER WELL DRILLERS LOG

2-17-78 date well completed
McDonald & Mill firm name
Newton county well located


LANDOWNER: Choctaw Utility	description of formations encountered	from	to
Pass Chickaway	clay	0	16
Rt 1 / Conhatta (mailing address)	sandy shale	16	70
WELL LOCATION: sec. 21 T 7 N R 10 E 1 miles E of Conhatta (distance) (direction) (nearest town)	shale	70	80
WELL PURPOSE: none (home, irrigation, municipal, industrial)	sand & shale	80	105
WELL COMPLETION DATA: (1) diameter (inches) 4"	shale	105	170
(2) total depth (feet) 420'	sand	170	190
(3) static water level (feet) 120' below top of ground.	lignite & shale	190	210
(4) casing PVC 320' (material) (depth)	sand	210	260
4" (size) if telescope see back.	sandy shale	260	305
(5) screen (length) (depth to top)	shale	305	355
(size) (material)	Rock & shells	355	390
(6) pump 3d 6000 (HP) (field gpm)	green sand & sandy shale	390	451
E (type power)			
(7) electric log (yes or no)			
(organization running log)			
(8) how well bottom plugged open			
DRILLERS REMARKS:			

RECEIVED
FEB 27 1978

MISS. BD. OF WATER COMMISSIONERS

If well telescopes please sketch and show depths.

GROUND LEVEL

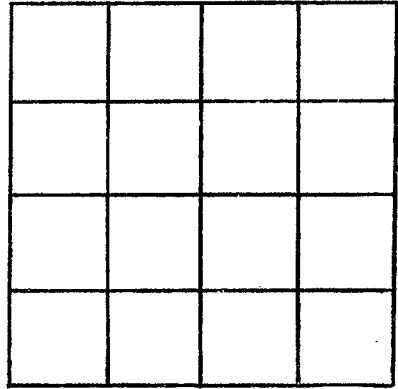

SECTION _____

Please indicate well location X.

ADDITIONAL INFORMATION

If more than one screen, show locations of each on sketch.