

NEWTON
E 2019
8-4-78

MISSISSIPPI
BOARD OF WATER COMMISSIONERS
416 North State Street
Jackson, Mississippi 39201

WATER WELL DRILLERS LOG

8-4-78 19 McDonnell & Well Newton
date well completed firm name county well located

LANDOWNER:
H.C. Blackburn
Rt # 2 Conehatta
(mailing address)

WELL LOCATION:
sec. 26 T. 7N R. 10E
2 miles SE of Conehatta
(distance) (direction) (nearest town)

WELL PURPOSE: home
(home, irrigation, municipal, industrial)

- WELL COMPLETION DATA:
- (1) diameter (inches) 4"
 - (2) total depth (feet) 440'
 - (3) static water level (feet) 188' below top of ground.
 - (4) casing PVC 365'
(material) (depth)
4" if telescope see back.
(size)
 - (5) screen _____
(length) (depth to top)
(size) (material)
 - (6) pump 30 beam
(HP) (yrd/d gpm)
E
(type power)
 - (7) electric log _____
(yes or no)
(organization running log)
 - (8) how well bottom plugged open

description of formations encountered	from	to
clay	0	10
sand	10	28
shale	28	35
rarely shale st sand	35	120
sand & shells	120	130
shale st sand	130	155
sand st shale	155	305
sandy shale	305	345
shale	345	392
sand & shells	392	425
green sand	425	440


RECEIVED
AUG 14 1978

MISS. BD. OF WATER COMMISSIONERS

DRILLERS REMARKS:

If well telescopes please sketch and show depths.

GROUND LEVEL

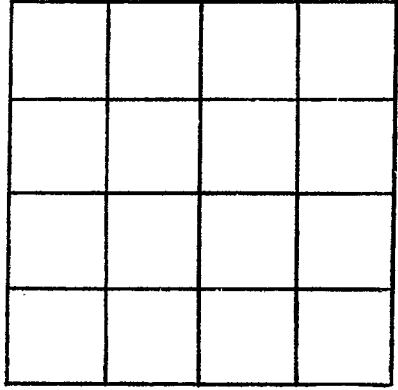

SECTION _____

Please indicate well location X.

ADDITIONAL INFORMATION

A series of horizontal lines for recording additional information, starting below the 'ADDITIONAL INFORMATION' header and extending to the bottom of the page.

If more than one screen, show locations of each on sketch.