

NEWTON
 E
 11-17-78
 2021

MISSISSIPPI
 BOARD OF WATER COMMISSIONERS
 416 North State Street
 Jackson, Mississippi 39201

WATER WELL DRILLERS LOG

NEWTON

11-17-78 date well completed
 McDonald & Hill firm name
 Newton county well located

LANDOWNER:
 Erby Pace
 Conhatta
 (mailing address)

WELL LOCATION:
 sec 5 T 7 N R 10 E
 S W
 2 miles N of Conhatta
 (distance) (direction) (nearest town)

WELL PURPOSE: none
 (home, irrigation, municipal, industrial)

WELL COMPLETION DATA:
 (1) diameter (inches) 4"
 (2) total depth (feet) 380'
 (3) static water level (feet) 110' below top of ground.
 (4) casing PVC 305'
 (material) (depth)
4" If telescope see back.
 (size)
 (5) screen _____
 (length) (depth to top)
 (size) (material)
 (6) pump 1/2 69.0 m
 (HP) (yield gpm)
E
 (type power)
 (7) electric log _____
 (yes or no)
 (organization running log)


description of formations encountered	from	to
clay & sand	0	20
sandy shale	20	60
sandy st. lignite	60	80
shale & st sand lignite	80	150
sand & shale	150	240
sandy shale	240	270
shale	270	324
Rock & sh o/s	324	350
green sandy sandy shale	350	380

DRILLERS REMARKS:

RECEIVED
 NOV 27 1978
 MISS. BD. OF WATER COMMISSIONERS

If well telescopes please sketch and show depths.

GROUND LEVEL

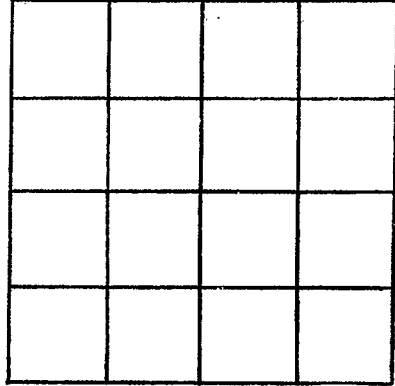

SECTION _____

Please indicate well location X.

ADDITIONAL INFORMATION

If more than one screen, show locations of each on sketch.