

NEWTON
E 2023
11-14-78

**MISSISSIPPI  
BOARD OF WATER COMMISSIONERS**  
416 North State Street  
Jackson, Mississippi 39201

**WATER WELL DRILLERS LOG**

11-14-78 19 McDonald & Hill Newton  
 date well completed firm name county well located

**LANDOWNER:**  
Lewis McDonald  
Conchatta  
 (mailing address)

**WELL LOCATION:**  
 sec. 17T 7N 10E  
1 1/2 miles W of Conchatta  
 (distance) (direction) (nearest town)

**WELL PURPOSE:** home  
 (home, irrigation, municipal, industrial)

**WELL COMPLETION DATA:**

(1) diameter (inches) 4"

(2) total depth (feet) 400'

(3) static water level (feet) 125' below top of ground.

(4) casing PVC 320'  
 (material) (depth)  
4" if telescope see back.  
 (size)

(5) screen \_\_\_\_\_  
 (length) (depth to top)  
 (size) (material)

(6) pump 30 60 gpm  
 (HP) (yell'd gpm)  
E  
 (type power)

(7) electric log \_\_\_\_\_  
 (yes or no)  
 (organization running log)

(8) how well bottom plugged open


description of formations encountered	from	to
clay & sand	0	30
shale	30	40
sandy shale	40	75
shale lignite & rot sand	75	130
sand	130	260
sandy shale	260	295
shale	295	349
sand & shells	349	380
green sand & sandy shale	380	400

**RECEIVED**  
 NOV 21 1978  
 MISS. BD. OF WATER COMMISSIONERS

**DRILLERS REMARKS:**

If well telescopes please sketch and show depths.

GROUND LEVEL

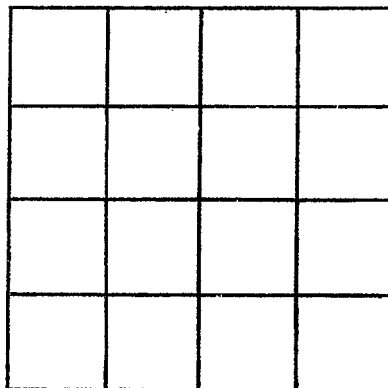

SECTION \_\_\_\_\_

Please indicate well location X.

ADDITIONAL INFORMATION

A series of horizontal lines for recording additional information, starting below the 'ADDITIONAL INFORMATION' header and extending down to the bottom of the page.

If more than one screen, show locations of each on sketch.