

NEWTON
E. 2024
3-14-78

**MISSISSIPPI
BOARD OF WATER COMMISSIONERS**
416 North State Street
Jackson, Mississippi 39201

WATER WELL DRILLERS LOG


3-14-78 19 McDonald & Hill Newton
 date well completed firm name county well located

LANDOWNER:	description of formations encountered	from	to
<u>Albert Stamps</u>	<u>clay & sand</u>	<u>0</u>	<u>17</u>
<u>Rt # 1 Conhatta</u> (mailing address)	<u>sandy shale</u>	<u>17</u>	<u>50</u>
WELL LOCATION:	<u>sand & shells</u>	<u>50</u>	<u>60</u>
sec <u>21</u> T <u>2</u> N R <u>10</u> E <u>1 1/2</u> miles S E of <u>Conhatta</u>	<u>sand & shale</u>	<u>60</u>	<u>250</u>
(distance) (direction) (nearest town)	<u>sandy shale</u>	<u>250</u>	<u>295</u>
WELL PURPOSE: <u>home</u> (home, irrigation, municipal, industrial)	<u>shale</u>	<u>295</u>	<u>336</u>
WELL COMPLETION DATA:	<u>Rocky shells</u>	<u>336</u>	<u>365</u>
(1) diameter (inches) <u>4"</u>	<u>3000 sand &</u>	<u>365</u>	<u>400</u>
(2) total depth (feet) <u>400'</u>	<u>1 sandy shale</u>		
(3) static water level (feet) <u>115'</u> below top of ground.			
(4) casing <u>PVC 310'</u> (material) (depth) <u>40'</u> if telescope see back. (size)			
(5) screen _____ (length) _____ (depth to top) (size) _____ (material)			
(6) pump <u>3/4</u> <u>McDM</u> (HP) (yield gpm) <u>F</u> (type power)			
(7) electric log _____ (yes or no) (organization running log)			
(8) how well bottom plugged <u>open</u>			
DRILLERS REMARKS:			

Miss. Board of Water Comm.
MAR 18 1978
RECEIVED

If well telescopes please sketch and show depths.

GROUND LEVEL

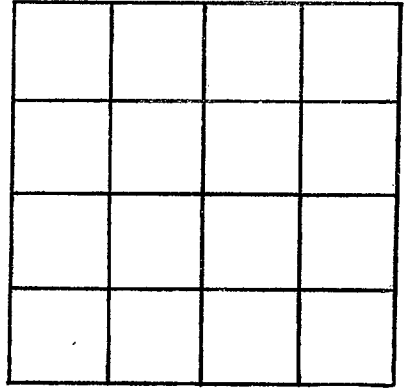

SECTION _____

Please indicate well location X.

ADDITIONAL INFORMATION

If more than one screen,
show locations of each on sketch.