

NEWTON
E 2025
3-13-78

**MISSISSIPPI
BOARD OF WATER COMMISSIONERS**
416 North State Street
Jackson, Mississippi 39201

WATER WELL DRILLERS LOG

3-13-78 19 McDonald & Hill Newton
 date well completed firm name county well located

LANDOWNER:	description of formations encountered	from	to
<u>Robert Ludlow</u>	<u>clay & sand</u>	<u>0</u>	<u>12</u>
<u>Rt # 1 Lawrence</u> (mailing address)	<u>sand & clay</u>	<u>12</u>	<u>47</u>
WELL LOCATION: sec. <u>34</u> T <u>7</u> N R <u>10</u> E <u>3</u> miles <u>S. E.</u> of <u>Conobatcha</u> (distance) (direction) (nearest town)	<u>shale</u>	<u>47</u>	<u>60</u>
	<u>sandy shale</u>	<u>60</u>	<u>130</u>
WELL PURPOSE: <u>home</u> (home, irrigation, municipal, industrial)	<u>sand & shale & lignite</u>	<u>130</u>	<u>200</u>
WELL COMPLETION DATA:	<u>sand</u>	<u>200</u>	<u>245</u>
(1) diameter (inches) <u>4 1/2"</u>	<u>shale & sand</u>	<u>245</u>	<u>265</u>
(2) total depth (feet) <u>440'</u>	<u>sand</u>	<u>265</u>	<u>325</u>
(3) static water level (feet) <u>142'</u> below top of ground.	<u>sandy shale</u>	<u>325</u>	<u>340</u>
(4) casing <u>PVC 3 1/2"</u> (material) (depth)	<u>shale</u>	<u>340</u>	<u>388</u>
<u>4 1/2"</u> (size) if telescope see back.	<u>Rock & shells</u>	<u>388</u>	<u>410</u>
(5) screen _____ (length) (depth to top)	<u>green sand & sandy shale</u>	<u>410</u>	<u>440</u>
(size) (material)			
(6) pump <u>30</u> <u>4000</u> (HP) (yield/gpm)			
(type power) <u>E</u>			
(7) electric log _____ (yes or no)			
(organization running log) _____			
(8) how well bottom plugged <u>Open</u>			
DRILLERS REMARKS:			


Misc. Board of Water Comm.

MAR 19 1979

RECEIVED

If well telescopes please sketch and show depths.

GROUND LEVEL

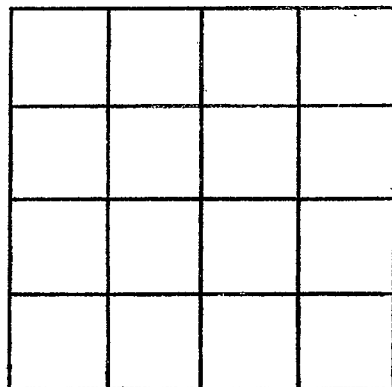

SECTION _____

Please indicate well location X.

ADDITIONAL INFORMATION

If more than one screen,
show locations of each on sketch.