

NEWTON  
E 2026  
2-23-79

MISSISSIPPI  
BOARD OF WATER COMMISSIONERS  
416 North State Street  
Jackson, Mississippi 39201

WATER WELL DRILLERS LOG

2-23-79 19 McDonald & Hill Newton  
date well completed firm name county well located

LANDOWNER:	description of formations encountered	from	to
Thomas Archie Conchatta (mailing address)			
WELL LOCATION:	sandy sh & ls & sand	20	100
sec. 29 T. 7 N. R. 10 E. 1 1/2 miles SW of Conchatta (distance) (direction) (nearest town)	sand & shale	100	140
WELL PURPOSE:	sand shales lignite	140	170
home (home, irrigation, municipal, industrial)	sand	170	270
WELL COMPLETION DATA:	sandy shale	270	310
(1) diameter (inches) 11"	shale	310	363
(2) total depth (feet) 420	Rock o. shells	363	390
(3) static water level (feet) 115 below top of ground.	Green sand & sandy shale		
(4) casing PVC 327 (material) (depth) 11" if telescope see back. (size)			
(5) screen (length) (depth to top) (size) (material)			
(6) pump 1 8000 (HP) (yield gpm) E (type power)			
(7) electric log (yes or no) (organization running log)			
(8) how well bottom plugged Open			
DRILLERS REMARKS:			


Miss. Board of Water Comm.

MAR 5 - 1979

RECEIVED

If well telescopes please sketch and show depths.

GROUND LEVEL

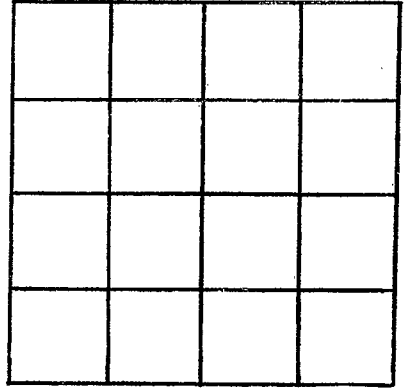

SECTION \_\_\_\_\_

Please indicate well location X.

ADDITIONAL INFORMATION

If more than one screen,  
show locations of each on sketch.