

NEWTON
E 2027
5-26-79

MISSISSIPPI
 BOARD OF WATER COMMISSIONERS
 416 North State Street
 Jackson, Mississippi 39201

WATER WELL DRILLERS LOG

5-26-79 19 McDonald + Hill Newton
 date well completed firm name county well located

LANDOWNER:	description of formations encountered	from	to
<u>Don Ferris</u>	<u>Clay + sand</u>	<u>0</u>	<u>12</u>
<u>P.O. Box 68, Conehatta</u> (mailing address)	<u>shale + sand</u>	<u>12</u>	<u>25</u>
WELL LOCATION: sec <u>7</u> T <u>7</u> N R <u>10</u> E <u>2</u> miles <u>N</u> of <u>Conehatta</u> (distance) (direction) (nearest town)	<u>sandy shale</u>	<u>25</u>	<u>40</u>
	<u>sand</u>	<u>40</u>	<u>50</u>
WELL PURPOSE: <u>home</u> (home, irrigation, municipal, industrial)	<u>sandy shale</u>	<u>50</u>	<u>100</u>
WELL COMPLETION DATA:	<u>sand + shale</u>	<u>100</u>	<u>165</u>
(1) diameter (inches) <u>4"</u>	<u>sand</u>	<u>165</u>	<u>270</u>
(2) total depth (feet) <u>420'</u>	<u>sandy shale</u>	<u>270</u>	<u>310</u>
(3) static water level (feet) <u>145'</u> below top of ground.	<u>shale</u>	<u>310</u>	<u>364</u>
(4) casing <u>PVC 3 3/8"</u> (material) <u>330'</u> (depth) <u>4"</u> (size) if telescope see back.	<u>Rock + shell</u>	<u>364</u>	<u>390</u>
(5) screen _____ (length) _____ (depth to top)	<u>open sand</u>	<u>390</u>	<u>420</u>
(6) pump <u>3/4</u> (HP) <u>102 gpm</u> (yield/gpm) <u>F</u> (type power)			
(7) electric log _____ (yes or no) (organization running log)			
(8) how well bottom plugged <u>Open</u>			
DRILLERS REMARKS:			


Miss. Board of Water Comm.

JUN - 6 1979

RECEIVED

If well telescopes please sketch and show depths.

GROUND LEVEL

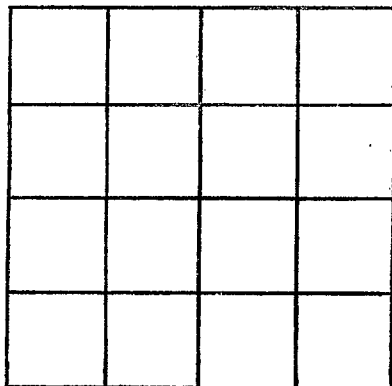

SECTION _____

Please indicate well location X.

ADDITIONAL INFORMATION

If more than one screen,
show locations of each on sketch.