

Newton
E 2029
12-3-79

MISSISSIPPI
BOARD OF WATER COMMISSIONERS
416 North State Street
Jackson, Mississippi 39201

WATER WELL DRILLERS LOG

12-3-79 19. McDonald & Hill Newton
date well completed firm name county well located

LANDOWNER:	description of formations encountered	from	to
J. W. Morrison	clay & sand	0	23
Rt # 1 Cornehalla (mailing address)	shale	23	50
WELL LOCATION: sec. 12 T. 7 N. R. 18 E 4 miles NE of Cornehalla (distance) (direction) (nearest town)	sand & shale	50	70
	sand	70	205
WELL PURPOSE: home (home, irrigation, municipal, industrial)	sandy shale	205	230
WELL COMPLETION DATA:	shale	230	280
(1) diameter (inches) 4"	Rocks & shells	280	310
(2) total depth (feet) 340'	green sand & sandy shale	310	340
(3) static water level (feet) 150' below top of ground.			
(4) casing PVC 260' (material) (depth) 4" (size) if telescope see back.			
(5) screen (length) (depth to top) (size) (material)			
(6) pump 3/4 69.0M. (HP) (yield gpm) E (type power)			
(7) electric log (yes or no) (organization running log)			
(8) how well bottom plugged OPEN			

DEPT. OF NATURAL RESOURCES
BUREAU OF LAND & WATER RESOURCES

DEC 11 1979


RECEIVED

Set Pump @ 200'

DRILLERS REMARKS: Go past mayer's place - take 1st dirt rd to right - 2nd Ranch house on right - tank goes in old pump house (40-50' water here)

If well telescopes please sketch and show depths.

GROUND LEVEL

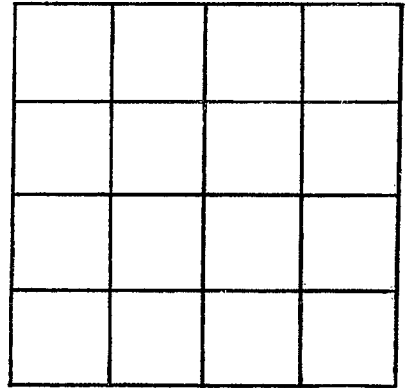

SECTION _____

Please indicate well location X.

ADDITIONAL INFORMATION

If more than one screen, show locations of each on sketch.