

NEWTON

E 2030

7-13-80

7-13-80

MISSISSIPPI
 BOARD OF WATER COMMISSIONERS
 416 North State Street
 Jackson, Mississippi 39201

WATER WELL DRILLERS LOG

19 McDonald & Hall Newton
 date well completed firm name county well located

LANDOWNER:	description of formations encountered	from	to
<u>Ed Welborn</u>	<u>clay & sand</u>	<u>0</u>	<u>16</u>
<u>Rt #1 Conehatta</u> (mailing address)	<u>shale</u>	<u>16</u>	<u>22</u>
WELL LOCATION:	<u>sandy shale w/ pink</u>	<u>22</u>	<u>80</u>
sec. <u>28</u> T. <u>7</u> N. R. <u>10</u> E S. W.	<u>shale</u>	<u>80</u>	<u>145</u>
<u>3</u> miles <u>S</u> of <u>Conehatta</u> (distance) (direction) (nearest town)	<u>sand</u>	<u>145</u>	<u>245</u>
WELL PURPOSE:	<u>sandy shale</u>	<u>245</u>	<u>300</u>
(home, irrigation, municipal, industrial)	<u>shale</u>	<u>300</u>	<u>340</u>
WELL COMPLETION DATA:	<u>rock & shells</u>	<u>340</u>	<u>370</u>
(1) diameter (inches) <u>2 1/2"</u>	<u>green sandstone & sandy shale</u>	<u>370</u>	<u>400</u>
(2) total depth (feet) <u>400</u>			
(3) static water level (feet) <u>100'</u> below top of ground.			
(4) casing <u>PVC</u> , <u>320'</u> (material) (depth)			
<u>4"</u> if telescope see back. (size)			
(5) screen _____ (length) (depth to top)			
(size) (material)			
(6) pump <u>1/2</u> <u>89 gpm</u> (HP) (yield gpm)			
<u>F</u> (type power)			
(7) electric log _____ (yes or no)			
(organization running log)			
(8) how well bottom plugged <u>open</u>			
DRILLERS REMARKS:			


DEPT. OF NATURAL RESOURCES
 BUREAU OF LAND & WATER RESOURCES

JUL 21 1980

RECEIVED

If well telescopes please
sketch and show depths.

GROUND LEVEL

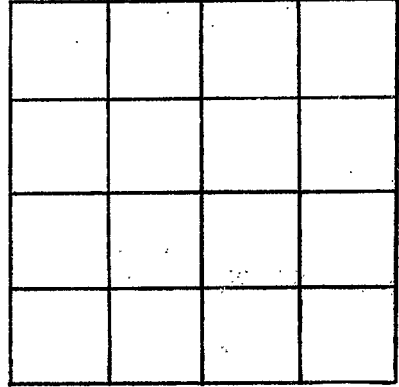

SECTION _____

Please indicate well location X.

ADDITIONAL INFORMATION

If more than one screen,
show locations of each on sketch.