

NEWTON

MISSISSIPPI BOARD OF WATER COMMISSIONERS
416 North State Street
Jackson, Mississippi 39201

F. 2031.

7-29-80

7-29-80

WATER WELL DRILLERS LOG

McDonald & Hill

Newton

date well completed

firm name

county well located

LANDOWNER:	description of formations encountered	from	to
Mickey Parker	clay & sand	0	18
Lawrence (mailing address)	sandy shale	18	100
WELL LOCATION:	sand & st shale	100	190
sec. 21 T 7 N R 10 E	sand	190	270
9 miles S of Cornhatta	sandy shale	270	310
(distance) (direction) (nearest town)	shale	310	365
WELL PURPOSE: home	Rock & shells	365	288
(home, irrigation, municipal, industrial)	green sand	388	400
WELL COMPLETION DATA:			
(1) diameter (inches) 4 x 2'			
(2) total depth (feet) 2100'			
(3) static water level (feet) 140' below top of ground.			
(4) casing PVC 340' (material) (depth)			
1 1/2" 63' 2" galv. (size) If telescope see pack.			
(5) screen 10' 990 to 400' (length) (depth to top)			
2" S.S. (size) (material)			
(6) pump 2 200 gpm (HP) (yield gpm)			
F (type power)			
(7) electric log (yes or no)			
(organization running log)			
(8) how well bottom plugged water			
DRILLERS REMARKS:			


DEPT. OF NATURAL RESOURCES
BUREAU OF LAND & WATER RESOURCES

AUG 4 1980

RECEIVED

If well telescopes please sketch and show depths.

GROUND LEVEL

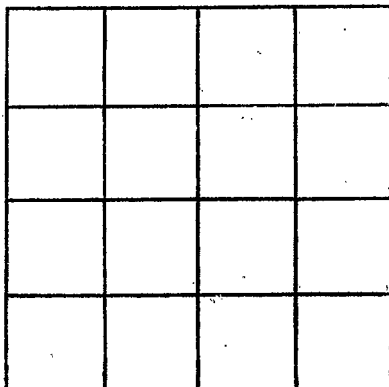

SECTION _____

Please indicate well location X.

ADDITIONAL INFORMATION

If more than one screen, show locations of each on sketch.