

NEWTON

E 2032

7-31-80
7-31-80

MISSISSIPPI
BOARD OF WATER COMMISSIONERS
416 North State Street
Jackson, Mississippi 39201

WATER WELL DRILLERS LOG

McDonald + Hill Newton
firm name county well located

LANDOWNER:
Robert Durhan
Rt # 1 Conehatta
(mailing address)

WELL LOCATION:
sec 26 T 7 N R 10 E
S W
4 miles SE of Conehatta
(distance) (direction) (nearest town)

WELL PURPOSE: home
(home, irrigation, municipal, industrial)

- WELL COMPLETION DATA:
- (1) diameter (inches) 4"
 - (2) total depth (feet) 460'
 - (3) static water level (feet) 180' below top of ground.
 - (4) casing PUC 380'
(material) (depth)
4" If telescope see back.
(size)
 - (5) screen _____
(length) (depth to top)
(size) (material)
 - (6) pump 30 600pm
(HP) (yld'd gpm)
E
(type power)
 - (7) electric log _____
(yes or no)
(organization running log)
 - (8) how well bottom plugged open

description of formations encountered	from	to
clay	0	20
sand	20	50
shale	50	70
sandy shale & shells	70	150
shale & sand	150	180
sand & shale	180	265
sand	265	305
sandy shale	305	355
shale	355	409
Rock & shells	409	435
green sand & sandy shale	435	460

DEPT. OF NATURAL RESOURCES
BUREAU OF LAND & WATER RESOURCES


AUG 4 1980

RECEIVED

DRILLERS REMARKS:

If well telescopes please sketch and show depths.

GROUND LEVEL

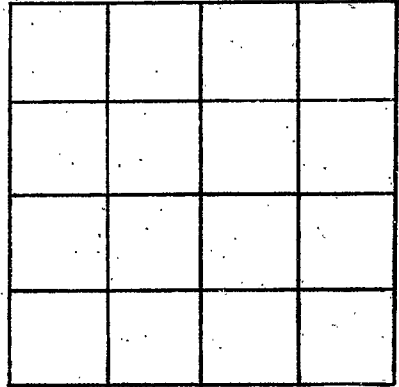

SECTION _____

Please indicate well location X.

ADDITIONAL INFORMATION

If more than one screen, show locations of each on sketch.