

MISSISSIPPI DEPARTMENT OF NATURAL RESOURCES

Bureau of Land and Water Resources

Southport Mall

P.O. Box 10631

Jackson, Mississippi 39209

WATER WELL DRILLERS LOG

Newton
E 2033
5/19/80
5-19-20


date well completed

firm name

county well located

19 McDonald & Well Newton


LANDOWNER:	description of formations encountered	from	to
<u>Marion Bradlock</u>	<u>clay & sand</u>	<u>0</u>	<u>20</u>
<u>Rt # 1 Decatur</u> (mailing address)	<u>sand & clay</u>	<u>20</u>	<u>70</u>
WELL LOCATION:	<u>shale</u>	<u>70</u>	<u>90</u>
sec. <u>36</u> <u>7</u> <u>N</u> <u>R-10</u> <u>E</u> <u>S</u> <u>W</u>	<u>sandy shale</u>	<u>90</u>	<u>150</u>
<u>8</u> miles <u>NW</u> of <u>Newton</u> (distance) (direction) (nearest town)	<u>shale & sand</u>	<u>150</u>	<u>250</u>
WELL PURPOSE: <u>home</u> (home, irrigation, municipal, industrial)	<u>sand</u>	<u>250</u>	<u>340</u>
WELL COMPLETION DATA:	<u>sandy shale</u>	<u>340</u>	<u>380</u>
(1) diameter (inches) <u>4"</u>	<u>shale</u>	<u>380</u>	<u>410</u>
(2) total depth (feet) <u>460'</u>	<u>Rock & shale</u>	<u>410</u>	<u>410</u>
(3) static water level (feet) <u>210'</u> below above top of ground.	<u>green sand & sandy shale</u>	<u>440</u>	<u>460</u>
(4) casing <u>PVC</u> <u>400'</u> (material) (depth) <u>4"</u> if telescope see back. (size)			
(5) screen (length) (depth to top) (size) (material)			
(6) pump <u>1</u> <u>690 m</u> (HP) (yield gpm) <u>E</u> (type power)			
(7) electric log (yes or no) (organization running log)			
(8) how well bottom plugged <u>open</u>			

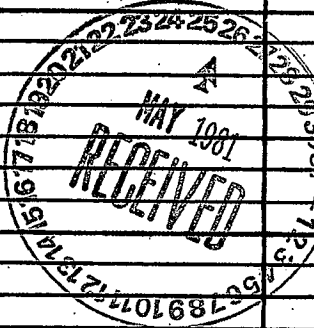

DRILLERS REMARKS: Go to Gulf Coast Dr - 7 1/2 miles
West - Go past Brecken Church - take
road to right - 2nd house on right

If well telescopes please
sketch and show depths.

GROUND LEVEL

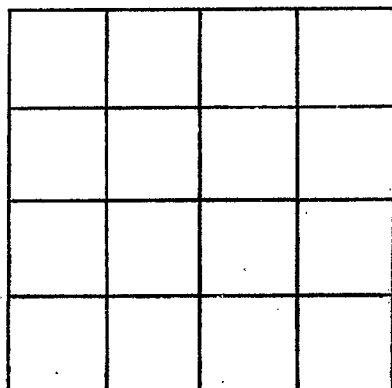

SECTION _____

Please indicate well location X.

ADDITIONAL INFORMATION

If more than one screen,
show locations of each on sketch.