

MISSISSIPPI DEPARTMENT OF NATURAL RESOURCES

Bureau of Land and Water Resources

Southport Mall

P.O. Box 10631


Jackson, Mississippi 39209

WATER WELL DRILLERS LOG

NEWTON
E 234
5/20/81

5-20-81 19 McDonald & Kill Newton
date well completed firm name county well located


| LANDOWNER: | description of formations encountered | from | to |
|---|---------------------------------------|------------|------------|
| <u>Frank Beckham</u> | <u>clay & sand</u> | <u>0</u> | <u>25</u> |
| <u>Rt# 1, Conehatta</u> (mailing address) | <u>shale</u> | <u>25</u> | <u>50</u> |
| WELL LOCATION: | <u>sandy shale</u> | <u>50</u> | <u>130</u> |
| sec <u>21</u> T <u>7</u> N R <u>10</u> E S W | <u>shale</u> | <u>130</u> | <u>150</u> |
| <u>2</u> miles <u>SE</u> of <u>Conehatta</u> (distance) (direction) (nearest town) | <u>sand & shale</u> | <u>150</u> | <u>190</u> |
| WELL PURPOSE: <u>home</u> (home, irrigation, municipal, industrial) | <u>sand</u> | <u>190</u> | <u>285</u> |
| WELL COMPLETION DATA: | <u>sandy shale</u> | <u>285</u> | <u>330</u> |
| (1) diameter (inches) <u>4"</u> | <u>shale</u> | <u>330</u> | <u>375</u> |
| (2) total depth (feet) <u>420'</u> | <u>rock & shells</u> | <u>375</u> | <u>405</u> |
| (3) static water level (feet) <u>155'</u> below above top of ground. | <u>green sand & sandy shale</u> | <u>405</u> | <u>420</u> |
| (4) casing <u>PVC 340'</u> (material) (depth) | | | |
| <u>4"</u> If telescope see back. (size) | | | |
| (5) screen _____ (length) (depth to top) | | | |
| (size) _____ (material) | | | |
| (6) pump <u>3/4</u> <u>8 g.p.m.</u> (HP) (yield gpm) | | | |
| <u>F</u> (type power) | | | |
| (7) electric log _____ (yes or no) | | | |
| _____ (organization running log) | | | |
| (8) how well bottom plugged <u>open</u> | | | |

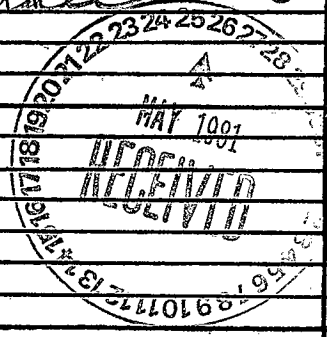

DRILLERS REMARKS:

If well telescopes please sketch and show depths.

GROUND LEVEL

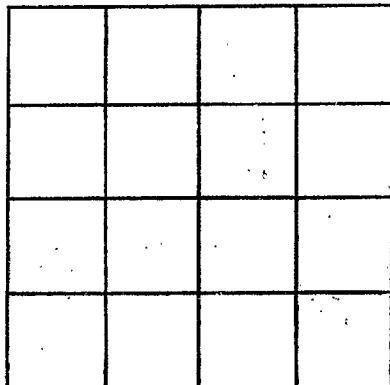

SECTION _____

Please indicate well location X.

ADDITIONAL INFORMATION

If more than one screen,
show locations of each on sketch.