

MISSISSIPPI DEPARTMENT OF NATURAL RESOURCES

Bureau of Land and Water Resources

Southport Mall

P.O. Box 10631

Jackson, Mississippi 39209

WATER WELL DRILLERS LOG


Newton
E 2035
7/14/81

7-14-81
 date well completed

McDonald & Hill
 firm name


Newton
 county well located

LANDOWNER:	description of formations encountered	from	to
(mailing address)			
<u>Claude Boykin</u>	<u>clay</u>	<u>0</u>	<u>10</u>
<u>At #1 Conchatta</u>	<u>sand</u>	<u>10</u>	<u>35</u>
(distance) (direction) (nearest town)	<u>shale</u>	<u>35</u>	<u>40</u>
WELL LOCATION:	<u>sandy shale</u>	<u>40</u>	<u>140</u>
sec <u>29</u> T <u>7</u> N R. <u>10</u> E	<u>shale & sand</u>	<u>140</u>	<u>185</u>
<u>2</u> miles <u>SW</u> of <u>Conchatta</u>	<u>lignite</u>		
(distance) (direction) (nearest town)	<u>sand</u>	<u>185</u>	<u>285</u>
WELL PURPOSE: <u>Home</u>	<u>sandy shale</u>	<u>285</u>	<u>320</u>
(home, irrigation, municipal, industrial)	<u>shale</u>	<u>320</u>	<u>370</u>
WELL COMPLETION DATA:	<u>Rocky shells</u>	<u>370</u>	<u>400</u>
(1) diameter (inches) <u>4"</u>	<u>green sandy & coarse shale</u>	<u>400</u>	<u>420</u>
(2) total depth (feet) <u>420'</u>			
(3) static water level (feet) <u>110'</u> below top of ground.			
(4) casing <u>PVC</u> , <u>340'</u> , (material) (depth) <u>4"</u> if telescope see back. (size)			
(5) screen _____ (length) _____ (depth to top) (size) _____ (material)			
(6) pump <u>3 1/2</u> <u>80 gpm</u> (HP) (y/e/d gpm) <u>E</u> (type power)			
(7) electric log _____ (yes or no) (organization running log)			
(8) how well bottom plugged <u>open</u>			
DRILLERS REMARKS:			

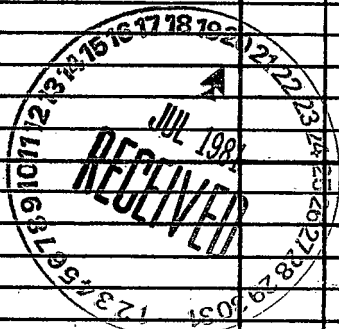

If well telescopes please sketch and show depths.

GROUND LEVEL

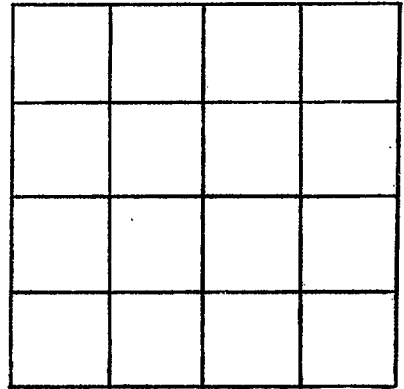

SECTION _____

Please indicate well location X.

ADDITIONAL INFORMATION

If more than one screen,
show locations of each on sketch.