

MISSISSIPPI DEPARTMENT OF NATURAL RESOURCES

Bureau of Land and Water Resources

Southport Mall

P.O. Box 10631

Jackson, Mississippi 39209

WATER WELL DRILLERS LOG

NEWTON
E 2336
9-21-81

9-21-81 date well completed McDonald & Mill firm name Newton county well located

LANDOWNER: <u>Edwin Thomas</u>	Description of formations encountered	from	to
<u>Choctaw Health Center</u>	<u>clay &amp; sand</u>	<u>0</u>	<u>20</u>
<u>Box B-50 Philadelphia</u> (mailing address)	<u>shale</u>	<u>20</u>	<u>50</u>
WELL LOCATION: sec. <u>21</u> -T- <u>7</u> <u>N</u> R. <u>10</u> <u>E</u> <u>2</u> miles <u>S</u> of <u>Conehatta</u> (distance) (direction) (nearest town)	<u>sandy shale</u>	<u>50</u>	<u>110</u>
WELL PURPOSE: <u>none</u> (home, irrigation, municipal, industrial)	<u>sand &amp; shell &amp; shale</u>	<u>110</u>	<u>130</u>
WELL COMPLETION DATA: (1) diameter (inches) <u>4"</u>	<u>shale &amp; lignite</u>	<u>130</u>	<u>280</u>
(2) total depth (feet) <u>420'</u>	<u>sandy shale</u>	<u>280</u>	<u>320</u>
(3) static water level (feet) <u>155'</u> below top of ground.	<u>shale</u>	<u>320</u>	<u>372</u>
(4) casing <u>PVC</u> , <u>340'</u> (material) (depth) <u>4"</u> if telescope see back. (size)	<u>shale &amp; shell</u>	<u>372</u>	<u>402</u>
(5) screen _____ (length) (depth to top) (size) (material)	<u>green sand &amp; sandy shale</u>	<u>402</u>	<u>420</u>
(6) pump <u>3/4</u> <u>4000</u> (HP) (y/e/d gpm) (type power)			
(7) electric log _____ (yes or no) (organization running log)			
(8) how well bottom plugged <u>open</u>			

DRILLERS REMARKS:


DEPT. OF NATURAL RESOURCES  
BUREAU OF LAND & WATER RESOURCES

SEP 28 1981

RECEIVED

If well telescopes please sketch and show depths.

GROUND LEVEL

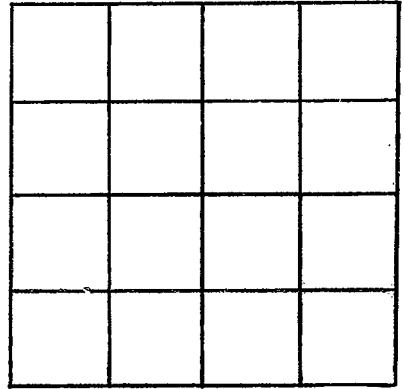

SECTION \_\_\_\_\_

Please indicate well location X.

ADDITIONAL INFORMATION

Lined area for additional information.

81 SEP 28 9:14  
RECEIVED

If more than one screen, show locations of each on sketch.