

Newton  
E  
237

MISSISSIPPI  
BOARD OF WATER COMMISSIONERS  
416 North State Street  
Jackson, Mississippi 39201

*out for 307*

WATER WELL DRILLERS LOG

Open 1982 McDonnell & Hillier Newton  
date well completed firm name county well located

LANDOWNER:  
Mrs. H. C. Blackburn  
PTH 2 Box 39 Conchatta, Ms  
(mailing address)

WELL LOCATION:  
sec. 26 T. 2 N. R. 10 E. S. 5 (W)  
10 miles northwest of Ulatia  
(distance) (direction) (nearest town)

WELL PURPOSE: Home  
(home, irrigation, municipal, industrial)

WELL COMPLETION DATA:

(1) diameter (inches) 4

(2) total depth (feet) 440

(3) static water level (feet) 168 below above top of ground.

(4) casing 4" PVC, 367'  
(material) (depth)  
\_\_\_\_\_ if telescope see back.  
(size)

(5) screen \_\_\_\_\_ (length) \_\_\_\_\_ (depth to top)  
(size) \_\_\_\_\_ (material)

(6) pump 3/4 \_\_\_\_\_ 8  
(HP) (yield gpm)  
\_\_\_\_\_ (type power)

(7) electric log \_\_\_\_\_ (yes or no)  
\_\_\_\_\_ (organization running log)

(8) how well bottom plugged open end

description of formations encountered	from	to
Clay + sand	0	32
shale	32	60
sandy st shale	60	100
shale	100	120
sandy st shells	120	140
shale	140	150
st sand	150	320
sandy st rock	320	350
hard shale	350	395
sandy st rock	395	425
coarse glen sand	425	440


DEPT. OF NATURAL RESOURCES  
BUREAU OF LAND & WATER RESOURCES

JAN 26 1982  
RECEIVED

DRILLERS REMARKS:

If well telescopes please sketch and show depths.

GROUND LEVEL

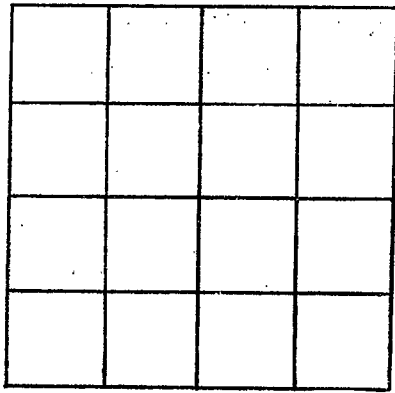

SECTION 36

Please indicate well location X.

ADDITIONAL INFORMATION

A series of horizontal lines for recording additional information, starting below the 'ADDITIONAL INFORMATION' header and extending to the bottom of the page.

If more than one screen, show locations of each on sketch.