

MISSISSIPPI DEPARTMENT OF NATURAL RESOURCES

Bureau of Land and Water Resources

Southport Mall

P.O. Box 10631

Jackson, Mississippi 39209

WATER WELL DRILLERS LOG

Newton  
E  
2038

5-5-82  
 date well completed

McDonald's Kill Newton  
 firm name

county well located

LANDOWNER:	description of formations encountered	from	to
<u>Mickey Parker</u>	<u>clay &amp; sand</u>	<u>0</u>	<u>25</u>
<u>Rt# 1 Conehatta</u> (mailing address)	<u>shale</u>	<u>25</u>	<u>45</u>
WELL LOCATION: sec <u>21</u> T <u>7</u> N R <u>10</u> E <u>9</u> miles <u>5</u> of <u>Conehatta</u> (distance) (direction) (nearest town)	<u>sandy shale &amp; shell</u>	<u>45</u>	<u>105</u>
	<u>shale st sand</u>	<u>105</u>	<u>180</u>
	<u>sand</u>	<u>180</u>	<u>275</u>
WELL PURPOSE: <u>home</u> (home, irrigation, municipal, industrial)	<u>sandy shale</u>	<u>275</u>	<u>320</u>
WELL COMPLETION DATA:	<u>shale</u>	<u>320</u>	<u>368</u>
(1) diameter (inches) <u>4"</u>	<u>rock &amp; shells</u>	<u>368</u>	<u>393</u>
(2) total depth (feet) <u>420'</u>	<u>green sand &amp; sandy shale</u>	<u>393</u>	<u>420</u>
(3) static water level (feet) <u>150'</u> below above top of ground.			
(4) casing <u>PVC</u> <u>340'</u> (material) (depth) <u>4"</u> (size) if telescope see back.			
(5) screen _____ (length) (depth to top) (size) (material)			
(6) pump <u>34</u> <u>89</u> <u>PM</u> (HP) (y/ld/gpm) <u>K</u> (type power)			
(7) electric log _____ (yes or no) (organization running log)			
(8) how well bottom plugged <u>open</u>			

DEPT. OF NATURAL RESOURCES  
 BUREAU OF LAND & WATER RESOURCES


MAY 17 1982

RECEIVED

DRILLERS REMARKS:

If well telescopes please sketch and show depths.

GROUND LEVEL

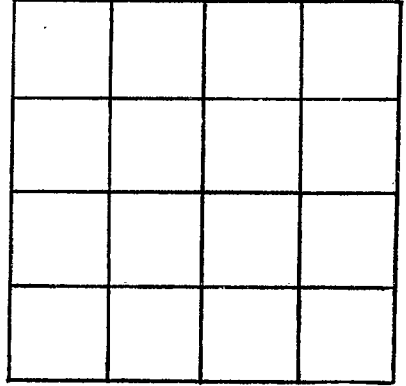

SECTION \_\_\_\_\_

Please indicate well location X.

ADDITIONAL INFORMATION

A series of horizontal lines for entering additional information, starting below the 'ADDITIONAL INFORMATION' header and extending to the bottom of the page.

If more than one screen, show locations of each on sketch.