

MISSISSIPPI DEPARTMENT OF NATURAL RESOURCES

Bureau of Land and Water Resources

Southport Mall

P.O. Box 10631

Jackson, Mississippi 39209

WATER WELL DRILLERS LOG

Newton

E

239

6-7-82 19 McDonald's Hill Newton

date well completed firm name county well located

LANDOWNER:	description of formations encountered	from	to
<u>L. T. McMill</u>	<u>Clay & sand</u>	<u>0</u>	<u>14</u>
<u>Cornehotta</u> (mailing address)	<u>sand</u>	<u>14</u>	<u>30</u>
WELL LOCATION: sec. <u>16</u> T. <u>7</u> N. R. <u>10</u> E S	<u>sandy shale & shell</u> <u>& RHP</u>	<u>30</u>	<u>170</u>
_____ miles _____ of <u>Cornehotta</u> (distance) (direction) (nearest town)	<u>shale & sand</u>	<u>170</u>	<u>240</u>
WELL PURPOSE: <u>water</u> (home, irrigation, municipal, industrial)	<u>sand</u>	<u>240</u>	<u>320</u>
WELL COMPLETION DATA:	<u>sandy shale</u>	<u>320</u>	<u>365</u>
(1) diameter (inches) <u>4"</u>	<u>shale</u>	<u>365</u>	<u>396</u>
(2) total depth (feet) <u>460'</u>	<u>rock & shells</u>	<u>396</u>	<u>425</u>
(3) static water level (feet) <u>185'</u> below top of ground.	<u>green sandy sandy</u>	<u>425</u>	<u>460</u>
(4) casing <u>PVC</u> <u>38'</u> (material) (depth)	<u>shale</u>		
<u>4"</u> (size) if telescope see back.			
(5) screen _____ (length) (depth to top)			
(size) _____ (material)			
(6) pump <u>30</u> <u>8 gpm</u> (HP) (yield gpm)			
<u>K</u> (type power)			
(7) electric log _____ (yes or no)			
(organization running log)			
(8) how well bottom plugged <u>open</u>			
DRILLERS REMARKS:			


DEPT. OF NATURAL RESOURCES
BUREAU OF LAND & WATER RESOURCES

JUN 15 1982

RECEIVED

If well telescopes please
sketch and show depths.

GROUND LEVEL

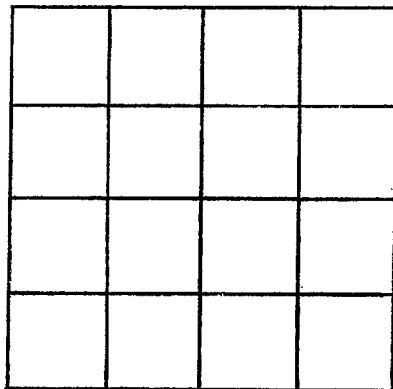

SECTION _____

Please indicate well location X.

ADDITIONAL INFORMATION

If more than one screen,
show locations of each on sketch.