

MISSISSIPPI DEPARTMENT OF NATURAL RESOURCES

Bureau of Land and Water Resources

Southport Mall

P.O. Box 10631

Jackson, Mississippi 39209

WATER WELL DRILLERS LOG

Newton
E
2041

2-15-82 19 McDonald + Hill Newton
 date well completed firm name county well located

LANDOWNER:	description of formations encountered	from	to
<u>Melvin Blackburn</u>	<u>clay</u>	<u>0</u>	<u>20</u>
<u>Conehatta</u> (mailing address)	<u>sand</u>	<u>20</u>	<u>80</u>
WELL LOCATION:	<u>shale</u>	<u>80</u>	<u>100</u>
sec. <u>16</u> -T- <u>7</u> N <u>3</u> R. <u>10</u> E	<u>sandy shale</u>	<u>100</u>	<u>180</u>
(distance) miles (direction) of <u>Conehatta</u> (nearest town)	<u>shale sand lignite</u>	<u>180</u>	<u>290</u>
WELL PURPOSE: <u>none</u> (home, irrigation, municipal, industrial)	<u>sand</u>	<u>290</u>	<u>320</u>
WELL COMPLETION DATA:	<u>sandy shale</u>	<u>320</u>	<u>340</u>
(1) diameter (inches) <u>4"</u>	<u>shale</u>	<u>340</u>	<u>405</u>
(2) total depth (feet) <u>460'</u>	<u>Rock & shells</u>	<u>405</u>	<u>430</u>
(3) static water level (feet) <u>135'</u> below above top of ground.	<u>green sand & sandy shale</u>	<u>430</u>	<u>460</u>
(4) casing <u>PVC</u> <u>381'</u> (material) (depth) <u>4 1/2"</u> if telescope see back. (size)			
(5) screen _____ (length) (depth to top) (size) (material)			
(6) pump <u>1</u> <u>80 gpm</u> (HP) (yield gpm) <u>E</u> (type power)			
(7) electric log _____ (yes or no) (organization running log)			
(8) how well bottom plugged <u>open</u>			

DEPT. OF NATURAL RESOURCES
 BUREAU OF LAND & WATER RESOURCES


FEB 22 1983

RECEIVED

DRILLERS REMARKS:

If well telescopes please sketch and show depths.

GROUND LEVEL

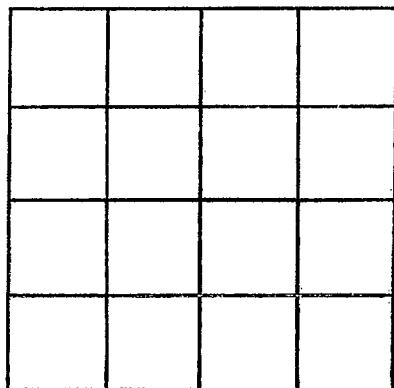

SECTION _____

Please indicate well location X.

ADDITIONAL INFORMATION

If more than one screen,
show locations of each on sketch.