

MISSISSIPPI DEPARTMENT OF NATURAL RESOURCES

Bureau of Land and Water Resources

Southport Mall

P.O. Box 10631

Jackson, Mississippi 39209

WATER WELL DRILLERS LOG

Newton
E
2042

8-15-83  
date well completed

McDonald & Hill  
firm name

Newton  
county well located

LANDOWNER:	description of formations encountered	from	to
w.p. Blackburn			
Conhatta (mailing address)	shale & sand	12	80
WELL LOCATION:	sand	80	160
sec. 14 T 7 N R 10 E S W	shale lignite & sand	160	175
3 miles E of Conhatta (distance) (direction) (nearest town)	sandy shale	175	200
WELL PURPOSE: home (home, irrigation, municipal, industrial)	shale	200	250
WELL COMPLETION DATA:	Rock & shale	250	280
(1) diameter (inches) 4"	green sand & sandy shale	280	295
(2) total depth (feet) 320	shale		
(3) static water level (feet) 150 below top of ground.	white sand & sandy shale	295	305
(4) casing PVC, 220' (material) (depth)	shale, Rock & sand	305	320
4" if telescope see back. (size)			
(5) screen (length) (depth to top)			
(size) (material)			
(6) pump 3/4 HP, 89 gpm (HP) (yield gpm)			
F (type power)			
(7) electric log (yes or no)			
(organization running log)			
(8) how well bottom plugged open			

DEPT. OF NATURAL RESOURCES  
BUREAU OF LAND & WATER RESOURCES


AUG 23 1983

RECEIVED

DRILLERS REMARKS:

If well telescopes please  
sketch and show depths.

GROUND LEVEL

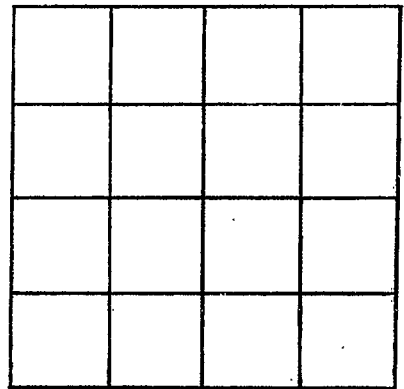

SECTION \_\_\_\_\_

Please indicate well location X.

ADDITIONAL INFORMATION

If more than one screen,  
show locations of each on sketch.