

MISSISSIPPI DEPARTMENT OF NATURAL RESOURCES

Bureau of Land and Water Resources

Southport Mall

P.O. Box 10631

Jackson, Mississippi 39209

WATER WELL DRILLERS LOG

Newton
E
2043

8-7-84
 date well completed

McDonald & Well
 firm name

Newton
 county well located

LANDOWNER:	description of formations encountered	from	to
Donald Auverette Rt # 1 Newton (mailing address)			
WELL LOCATION:	sandy shale	25	60
sec. <u>24</u> T <u>7</u> N R <u>10</u> E S W	sand & shale	60	100
<u>4</u> miles <u>E</u> of <u>Conclata</u> (distance) (direction) (nearest town)	sand	100	160
WELL PURPOSE: <u>home</u> (home, irrigation, municipal, industrial)	shale	160	190
WELL COMPLETION DATA:	sand	190	225
(1) diameter (inches) <u>4"</u>	sandy shale	225	260
(2) total depth (feet) <u>360'</u>	shale	260	298
(3) static water level (feet) <u>190'</u> below top of ground.	Rock & shells	298	320
(4) casing <u>PVC</u> , <u>280'</u> (material) (depth)	green sand & sandy shale	320	330
<u>4"</u> if telescope see back. (size)	Rock shale & sand	330	360
(5) screen _____ (length) (depth to top)			
(size) _____ (material)			
(6) pump <u>P</u> <u>200m</u> (HP) (yield gpm)			
(type power) <u>E</u>			
(7) electric log _____ (yes or no)			
(organization running log) _____			
(8) how well bottom plugged <u>Open</u>			
DRILLERS REMARKS:			


DEPT. OF NATURAL RESOURCES
 BUREAU OF LAND & WATER RESOURCES

AUG 10 1984

RECEIVED

If well telescopes please sketch and show depths.

GROUND LEVEL

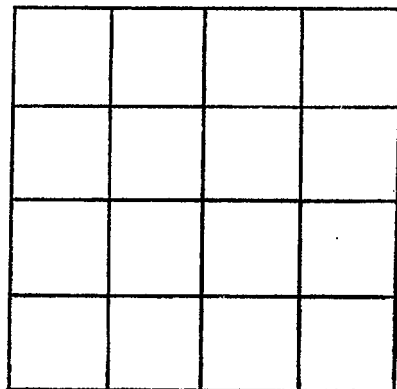

SECTION _____

Please indicate well location X.

ADDITIONAL INFORMATION

If more than one screen,
show locations of each on sketch.