

NEWTON

F2  
10-5-60

7300

WATER WELL DRILLERS LOG

Forest Drilling

Date: 10/5, 1960, Driller: James McGee, County: Newton  
(Name)

(1) Owner of Land: Mrs. R/ C. Atkinson  
(Name)  
Rt. 3 Decatur, Miss.  
(Address)

(2) Location: 1/4, 1/4, Sec. 29 T 7<sup>N</sup> R 11<sup>E</sup>  
8 miles North of Newton  
(distance) (direction) (Nearest Town)

(3) Topography:  (Hilly)  (Flat)  (Level)

(4) Purpose of Well: Domestic  
(Domestic Irrigation, Municipal, Industrial, Other)

Description & Color of Materials Sand, Clay, Red Clay, Shell, etc.	Thick- ness Feet	Depth Feet
Red clay.	0	12
Sand.	12	22
Red sand.	22	32
Sand.	32	41
Clay.	41	60
Clay & rock.	60	72
Clay.	72	82
Clay & shell.	82	112
Clay.	112	137
Rock.	137	138
Sandy shell.	138	142
Clay.	142	152
Sand. (Screen Set)	152	181

Information upon completion of well:

(1) Diameter 2 inches.

(2) Total Depth 181 feet.

(3) Water Level 149 feet below top of ground.

(4) Cased to 144', Size 2"


(5) Screen: Size 2", Length 5'

(6) Were any formations sealed against pollution?  
yes,  no.

If YES depth of formation \_\_\_\_\_

Why \_\_\_\_\_

Drillers Remarks: Fair well

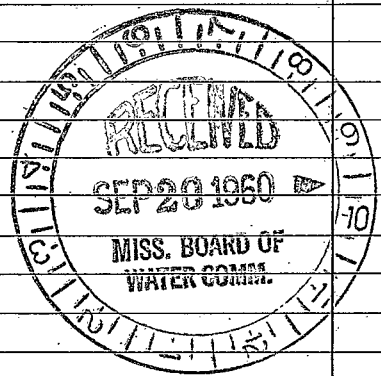

(Use Back Side)

Well No.

[The page contains extremely faint and illegible text, likely bleed-through from the reverse side of the document. No specific words or phrases can be discerned.]