

NEWTON MISSISSIPPI BOARD OF WATER COMMISSIONERS

FX  
12-8-60

*info to locate*

WATER WELL DRILLERS LOG

*Eor 7*

Date: 12/8, 1960, Driller: James McGee County: Newton  
(Name)

(1) Owner of Land: Calhoun Davis  
(Name)  
Decatur, Miss.  
(Address)

(2) Location: 1/4, 1/4, Sec. 18 T 7N R WE  
7 miles West of Decatur  
(distance) (direction) (Nearest Town)

(3) Topography: X  
(Hilly) (Flat) (Level)

(4) Purpose of Well: Domestic  
(Domestic Irrigation  
Municipal, Industrial, Other)

Description & Color of Materials Sand, Clay, Red Clay, Shell, etc.	Thick- ness Feet	Depth Feet
Red clay.	0	28
Blue clay.	28	114
Silt.	114	118
Blue clay.	118	144
Silt & Stks. clay.	144	164
Sand & Stks. clay.	164	184
Clay.	184	186
Sand. (Screen Set.)	186	205
Blue clay.	205	246

Information upon completion of well:

(1) Diameter 2 inches.

(2) Total Depth 201 feet.

(3) Water Level 130 feet below top of ground.


(4) Cased to 191', Size 2"

(5) Screen: Size 2", Length 10'

(6) Were any formations sealed against pollution?  
yes, X no.

*Same well  
as 123  
3/19/68  
B.H. 4665*

If YES depth of formation \_\_\_\_\_  
Why \_\_\_\_\_  
Drillers Remarks: Good well

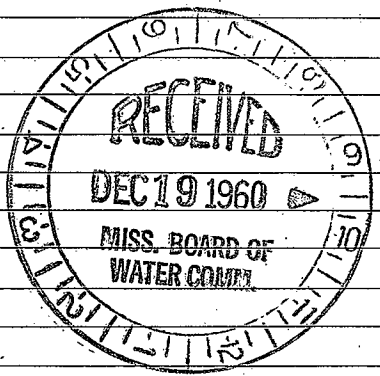

(Use Back Side)

Well No.

