

KFA
8-9-62

WATER WELL DRILLERS LOG

Date: Aug 9, 1962, Driller: Roy Wilkerson County Newton
(Name)

(1) Owner of Land: Mr. Simmons
(Name)
Newton Miss
(Address)

(2) Location: 1/4, 1/4, Sec. 32 T^{7N} R^{11E}
7 miles N of Newton
(distance) (direction) (Nearest Town)

(3) Topography: Hilly -
(Hilly) (Flat) (Level)


(4) Purpose of Well: Domestic
(Domestic Irrigation
Municipal, Industrial, Other)

Description & Color of Materials Sand, Clay, Red Clay, Shell, etc.	Thick- ness Feet	Depth Feet
Top Soil	1	
Red Clay	33	
Blue mud & Shell	71	
Water B. Sand	30	

Information upon completion of well:

- (1) Diameter 2 inches.
- (2) Total Depth 137 feet.
- (3) Water Level 45 feet below top of ground.
- (4) Cased to 137 ft, Size 2"
- (5) Screen: Size 2", Length 6 ft.
- (6) Were any formations sealed against pollution?
_____ yes, _____ no.

If YES depth of formation _____
Why _____
Drillers Remarks: _____

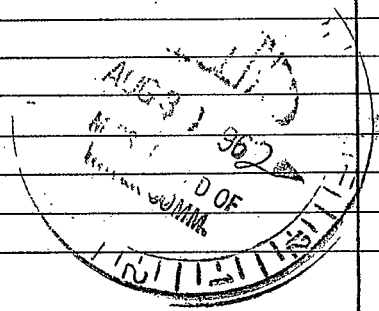

(Use Back Side)

Well No.

