

5 NEWTON

9

F5

WATER WELL DRILLERS LOG

5-13-63

Date: 5-13, 1963, Driller: Ray Cox (Name) John Comans County Newton

(1) Owner of Land: W.C. Harris  
 (Name)  
Decatur Miss  
 (Address)

(2) Location: 1/4, 1/4, Sec. 35 T. 7. R. 11,  
3 miles S. W of Decatur  
 (distance) (direction) (Nearest Town)

(3) Topography: X  
 (Hilly) (Flat) (Level)

(4) Purpose of Well: Domestic  
 (Domestic Irrigation  
 Municipal, Industrial, Other)

Description & Color of Materials Sand, Clay, Red Clay, Shell, etc.	Thick- ness Feet	Depth Feet
Red Clay	0	10
Robin Chalk	10	20
Gray Chalk	20	25
Gray sandy Chalk	25	38
Light Gray sand	38	120
Lignite Bed	120	130
with Red Chalk		
Ledges		
Robin Chalk		
Red Call Zirconia	130	185
Clay		
Shell & Marine		
Mixed with Iron		
Sand	185	210
Brown sand		
Red Sulphur T. B		
The Winona	210	230
Sand		
<del>Base</del>		

Information upon completion of well:

(1) Diameter 2 inches.

(2) Total Depth 231 feet.

(3) Water Level 92 feet below top of ground.

(4) Cased to 159, Size 2

(5) Screen: Size \_\_\_\_\_, Length \_\_\_\_\_

(6) Were any formations sealed against pollution?  
 \_\_\_\_\_ yes, \_\_\_\_\_ no.

If YES depth of formation \_\_\_\_\_


Why \_\_\_\_\_

Drillers Remarks: OPEN Bottom

Winona sand

Consent Water Well Drilling

Subsequent Drilling

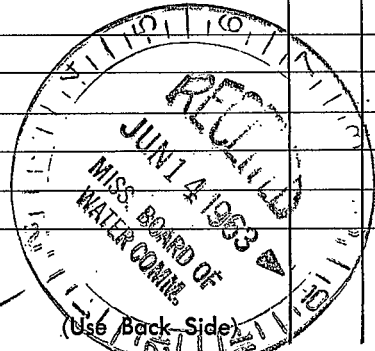

Well No.

