

NEWTON

F6

MISSISSIPPI BOARD OF WATER COMMISSIONERS

1966

3

WATER WELL DRILLERS LOG


Date: _____, 19____, Driller: LEACH County Newton
(When well drilled) (Name) (Where well is located)

(1) Owner of Land: _____
(Name)
A. A. Ezell
(Address)
(2) Location: $\frac{1}{4}$, $\frac{1}{4}$, Sec 23 T^N R^{11E}
2 miles West of Deer Creek
(distance) (direction) (Nearest Town)
(3) Topography: (Hilly) (Flat) (Level)
(4) Purpose of Well:
(Domestic Irrigation
Municipal, Industrial, Other)

Description & Color of Materials Sand, Clay, Red Clay, Shell, etc.	Thick-ness Feet	Depth Feet
red clay	25	25
blue clay	30	55
Rocky	50	105
Shell	30	135
Sand & Rock	30	165
Sand	29	194

Information upon completion of well:

(1) Diameter 2" inches.
(2) Total Depth 194 feet.
(3) Water Level 150 feet below top of ground.
(4) Cased to 189, Size 2"
(5) Screen: Size 2", Length 5'
(6) Were any formations sealed against pollution?
_____ yes, no.
If YES depth of formation _____
Why _____
Drillers Remarks: low water level
Yield in gpm: 6
Size pump: 1 HP
Type power: _____

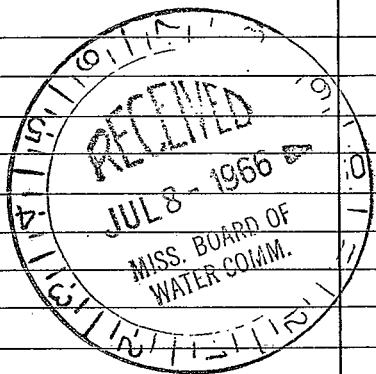

Total 194

