

NEWTON

F 8

5-68

MISSISSIPPI
 BOARD OF WATER COMMISSIONERS
 416 North State Street
 Jackson, Mississippi 39201

WATER WELL DRILLERS LOG

5-3

1968

CORRENS DRILLING SERVICE

Monter

date well completed

firm name

county well located

LANDOWNER: Robert Horton

Rt # 2 Coruhatta

Miss

(mailing address)

WELL LOCATION:

sec. 11 T. 7 N R. 10 E
 S W
 7 miles S of Union
 (distance) (direction) (nearest town)

WELL PURPOSE: Home
 (home, irrigation, municipal, industrial)

WELL COMPLETION DATA:

- (1) diameter (inches) 2"
- (2) total depth (feet) 300
- (3) static water level (feet) 120 below above top of ground.
- (4) casing 2 3/4 (material), 231 (depth),
 (size) if telescope see back.
- (5) screen (length), (depth to top)
 (size), (material)
- (6) pump (HP), (yield gpm)
 (type power)
- (7) electric log (yes or no)
 (organization running log)
- (8) how well bottom plugged

description of formations encountered

from

to


Clay	0	70
Sand + Clay	70	120
Coarse Sand	120	165
Clay	165	185
Sand	185	215
Clay	215	235
Sand	235	300

DRILLERS REMARKS:

5-15-1968
 MISSISSIPPI BOARD OF
 WATER COMMISSIONERS

If well telescopes please sketch and show depths.

GROUND LEVEL

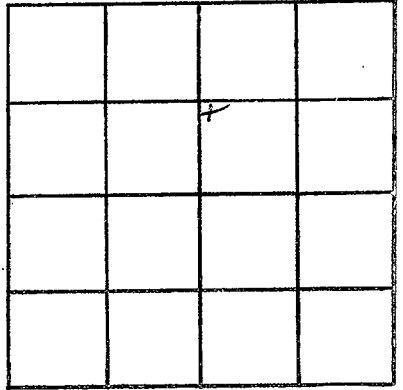

SECTION _____

Please indicate well location X.

ADDITIONAL INFORMATION

If more than one screen, show locations of each on sketch.