

3 13P 322425N 0890825

TESS?

NEWTON  
F9  
10-15-68

MISSISSIPPI  
BOARD OF WATER COMMISSIONERS  
416 North State Street  
Jackson, Mississippi 39201

WATER WELL DRILLERS LOG

10-15-68 date well completed  
MCDONALD + HILL firm name  
NEWTON county well located

LANDOWNER: SALLIE THORNTON

description of formations encountered

from to

DECATUR MISS  
(mailing address)

Pls. of sand	0	30
sandy sh. shale	30	44
shale	44	110
sand	110	133
shale	133	168
sand	168	260
salt sandy shale	260	275
shale	275	330
sand	330	360

WELL LOCATION:  
sec. 35 T 7 N R 11 E  
S W  
5 miles WEST of DECATUR  
(distance) (direction) (nearest town)

WELL PURPOSE: HOME  
(home, irrigation, municipal, industrial)

WELL COMPLETION DATA:

- (1) diameter (inches) 4" WELL
- (2) total depth (feet) 360'
- (3) static water level (feet) 185' below top of ground.
- (4) casing BLACK 280' (material) (depth)  
4" if telescope see back. (size)
- (5) screen (length) (depth to top) (size) (material)
- (6) pump 240 (HP) 10 (yield gpm)  
920 (type power)
- (7) electric log NO (yes or no)  
N/A (organization running log)
- (8) how well bottom plugged OPEN

DRILLERS REMARKS:


OCT 19 1968

MISS. Bd. OF WATER COMM.

CODED

If well telescopes please  
sketch and show depths.

GROUND LEVEL

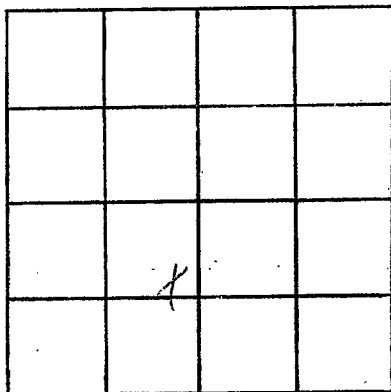

SECTION \_\_\_\_\_

Please indicate well location X.

ADDITIONAL INFORMATION

If more than one screen,  
show locations of each on sketch.