

Newton
7 12
12-11-68

MISSISSIPPI
BOARD OF WATER COMMISSIONERS
416 North State Street
Jackson, Mississippi 39201

Coded

WATER WELL DRILLERS LOG

CODED

12-11-68 date well completed
McDonald + Hill firm name
NEWTON county well located

LANDOWNER: N. W. Willis
R#3 DECATOR

description of formations encountered

from to

(mailing address)
WELL LOCATION:
sec. 20 T. 07 N. R. 11 E
S W
4 miles WEST of DECATOR
(distance) (direction) (nearest town)

CLAY ST SAND	0	40
SHALE ST ROCK	40	72
SAND ST SHELLS	72	90
SHALE	90	150
SAND ST SHALE	150	290
SOFT SHALE	290	315
SHALE	315	360
ROCK ST SHALE	360	390
SAND	390	420

WELL PURPOSE: HOME
(home, irrigation, municipal, industrial)

WELL COMPLETION DATA:

- (1) diameter (inches) 4" WELL
- (2) total depth (feet) 420
- (3) static water level (feet) 250 below/above top of ground.
- (4) casing BLACK 315' (material) (depth)
4" (size) if telescope see back.
- (5) screen _____ (length) _____ (depth to top)

(size) (material)
- (6) pump 1 (HP) 10 (yield gpm)
220 (type power)
- (7) electric log NO (yes or no)
NO (organization running log)
- (8) how well bottom plugged OPEN


DEC 10 1968

MISS. BD. OF
WATER COMM.

DRILLERS REMARKS:

If well telescopes please sketch and show depths.

GROUND LEVEL

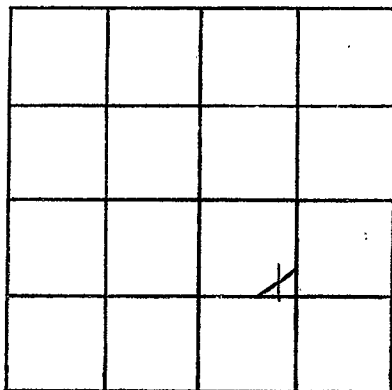

SECTION 20

Please indicate well location X.

• ADDITIONAL INFORMATION

If more than one screen, show locations of each on sketch.