

Newton  
713  
7-2-68

MISSISSIPPI  
 BOARD OF WATER COMMISSIONERS  
 416 North State Street.  
 Jackson, Mississippi 39201

**CODED**

WATER WELL DRILLERS LOG

7-2 1968 Cannon Drilling Service Newton  
 date well completed firm name county well located

LANDOWNER: Albert Bender

description of formations encountered

from to

R#1 Domestic Main

<u>Clay</u>	<u>8</u>	<u>70</u>
<u>Thin Sand</u>	<u>70</u>	<u>85</u>
<u>Clay &amp; Shell</u>	<u>85</u>	<u>208</u>
<u>Shell</u>	<u>208</u>	<u>246</u>
<u>Clay</u>	<u>246</u>	<u>300</u>
<u>Sand &amp; Shell</u>	<u>300</u>	<u>340</u>

(mailing address)

WELL LOCATION:

sec. 11 T 7 N R 11 E  
 S W  
3 miles N.W. of Newton  
 (distance) (direction) (nearest town)

WELL PURPOSE:  
 (home, irrigation, municipal, industrial)

WELL COMPLETION DATA:

- (1) diameter (inches) 2"
- (2) total depth (feet) 294
- (3) static water level (feet) 130 below above top of ground.
- (4) casing steel, 294,  
 (material) (depth)  
         If telescope see back.  
 (size)
- (5) screen         ,           
 (length) (depth to top)  
        ,           
 (size) (material)
- (6) pump 1 1/2 200 GPH  
 (HP) (yield gpm)  
          
 (type power)
- (7) electric log X  
 (yes or no)  
          
 (organization running log)
- (8) how well bottom plugged

**CODED**


FEB 12 1969

MISS. BD. OF  
 WATER COMM.

DRILLERS REMARKS: Open Bottom

If well telescopes please sketch and show depths.

GROUND LEVEL

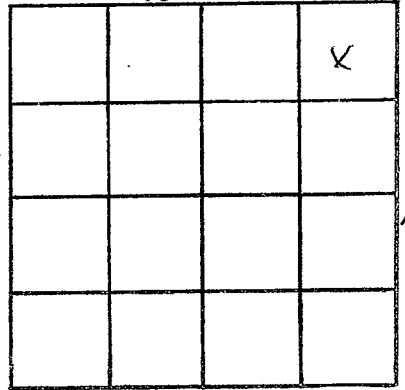

SECTION 11

Please indicate well location X.

**ADDITIONAL INFORMATION**

If more than one screen, show locations of each on sketch.